


T.25S.R.5W.W.M.

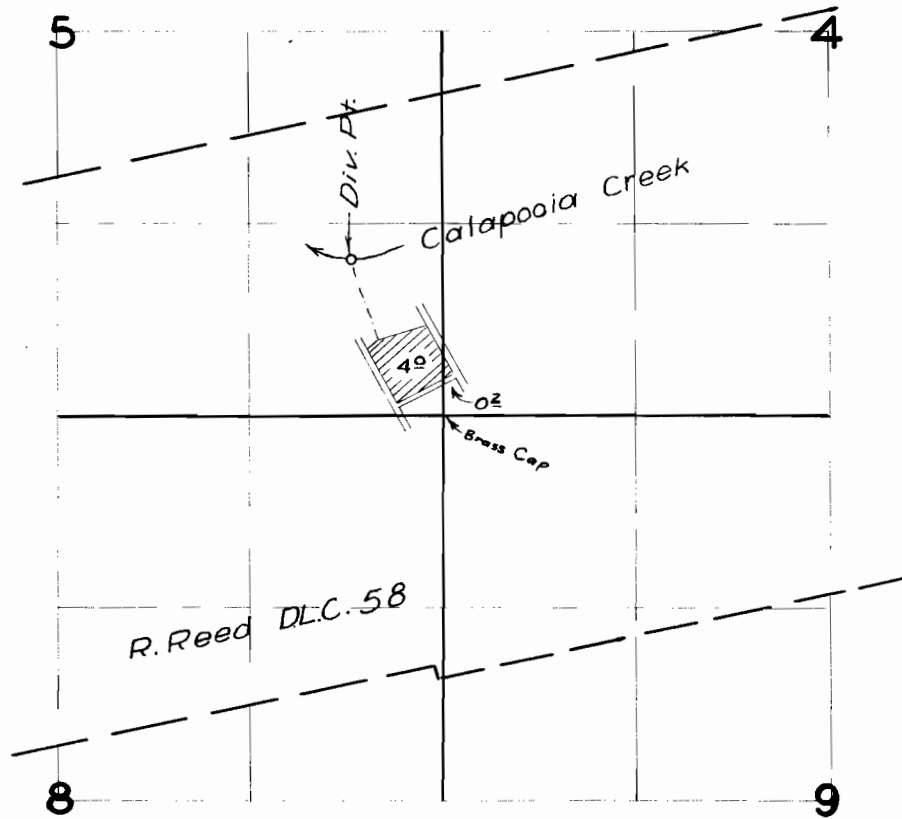

FINAL PROOF SURVEY UNDER

Application No. 29758 Permit No. 23437
IN NAME OF

Lee J. Treadwell

Surveyed Aug. 21, 1957, by M. Bish