


T.27S.R.6W.W.M.

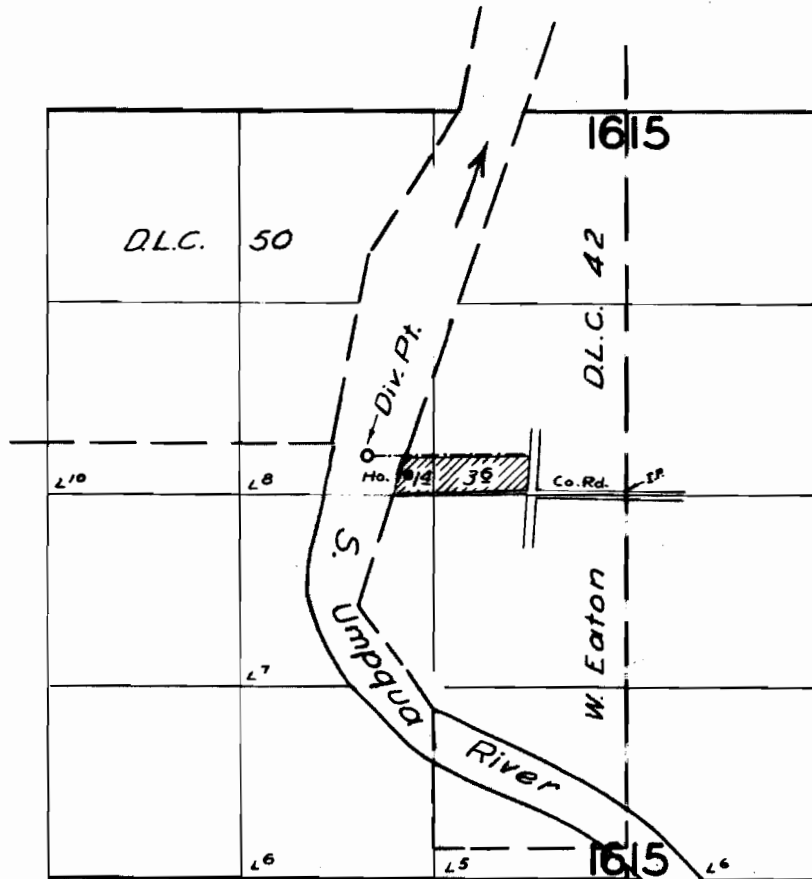

FINAL PROOF SURVEY

UNDER

Application No. 29661 Permit No. 23499

IN NAME OF

J.W. & Margaret Doyle

Surveyed July 18, 1957, by M. Bish