


T.28S.R.7W.W.M.

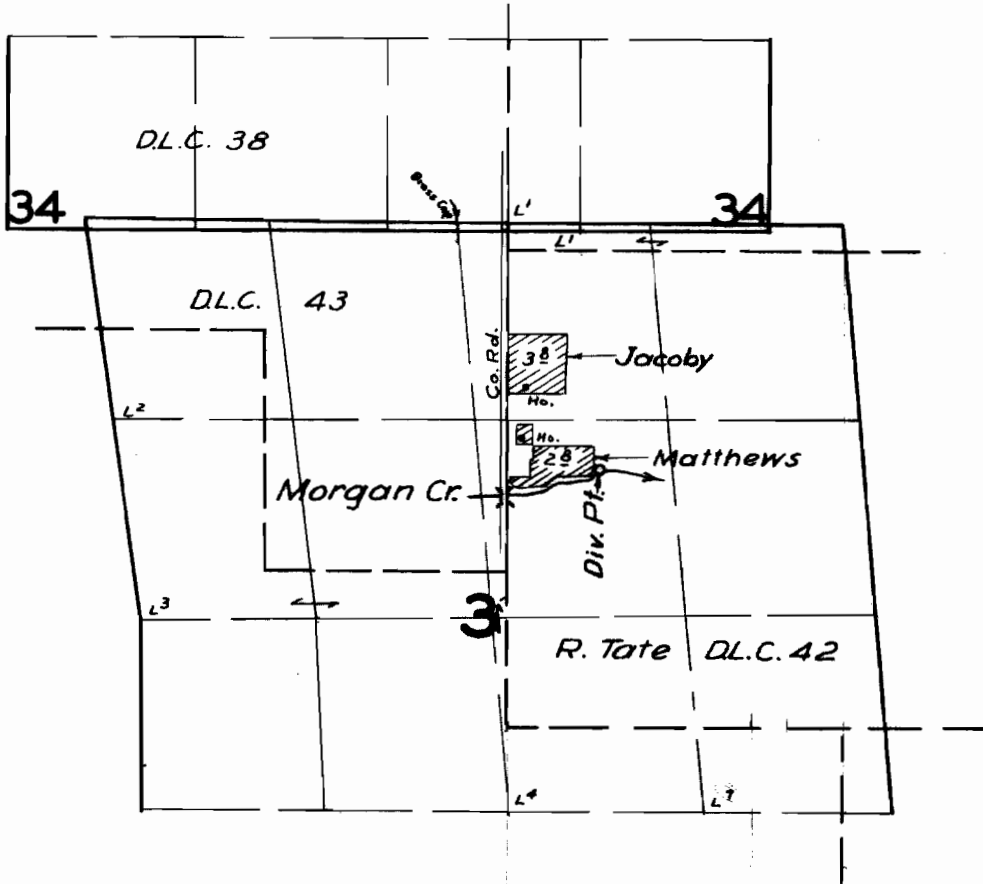

FINAL PROOF SURVEY
UNDER

Application No. 29707 Permit No. 23502
IN NAME OF

Ivan M. Matthews & A.A. Jacoboy

Surveyed July 21 1957, by M. Bick