


T.5 S.R.1 W.W.M.

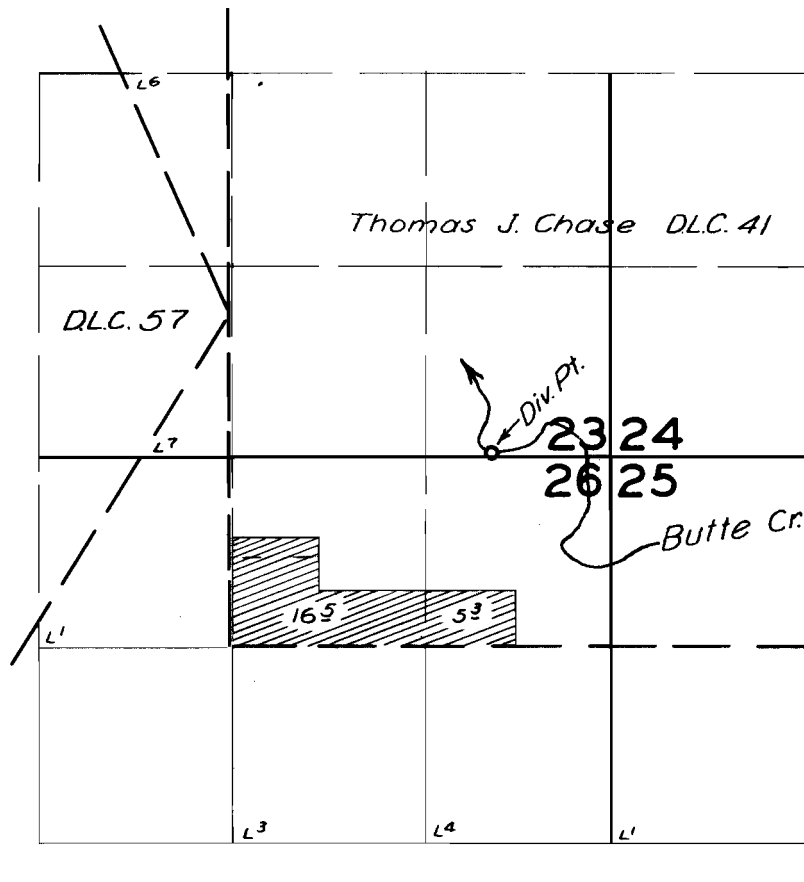

FINAL PROOF SURVEY UNDER

Application No. 31373 Permit No. 24735

IN NAME OF

ALAN OBERSINNER

Surveyed Aug. 19 1957, by C.O. Bartels