


T.8S.R.2W.W.M.

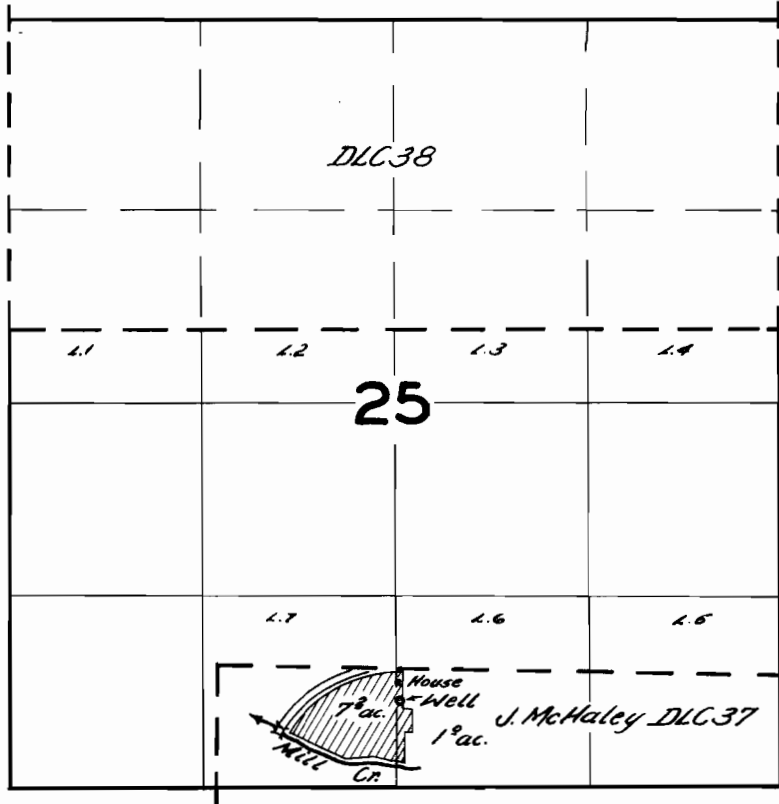

FINAL PROOF SURVEY
UNDER

Application No. *G-100* Permit No. *G-19*
IN NAME OF

Calvin D. Garver

Surveyed *April 3, 1957*, by *C.O. Smith*