


# T. 6N. R. 35E. W.M.

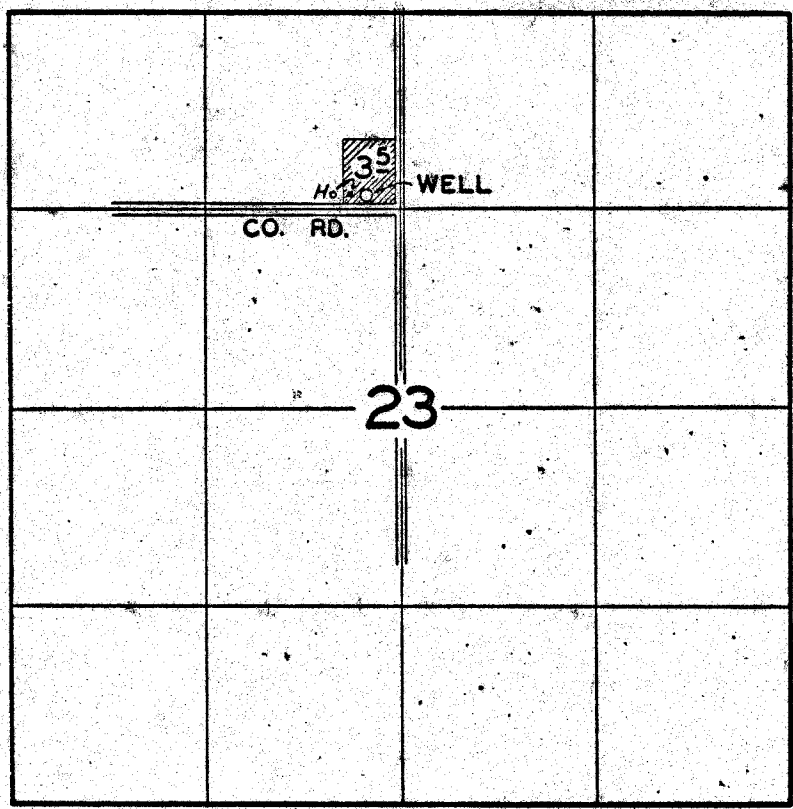

## FINAL PROOF SURVEY UNDER

Application No. G-142 Permit No. G-52  
IN NAME OF

W.F. RAMEY

Surveyed June 2 1957, by C.O. Britts