


T.40 S., R.19 E. W.M.

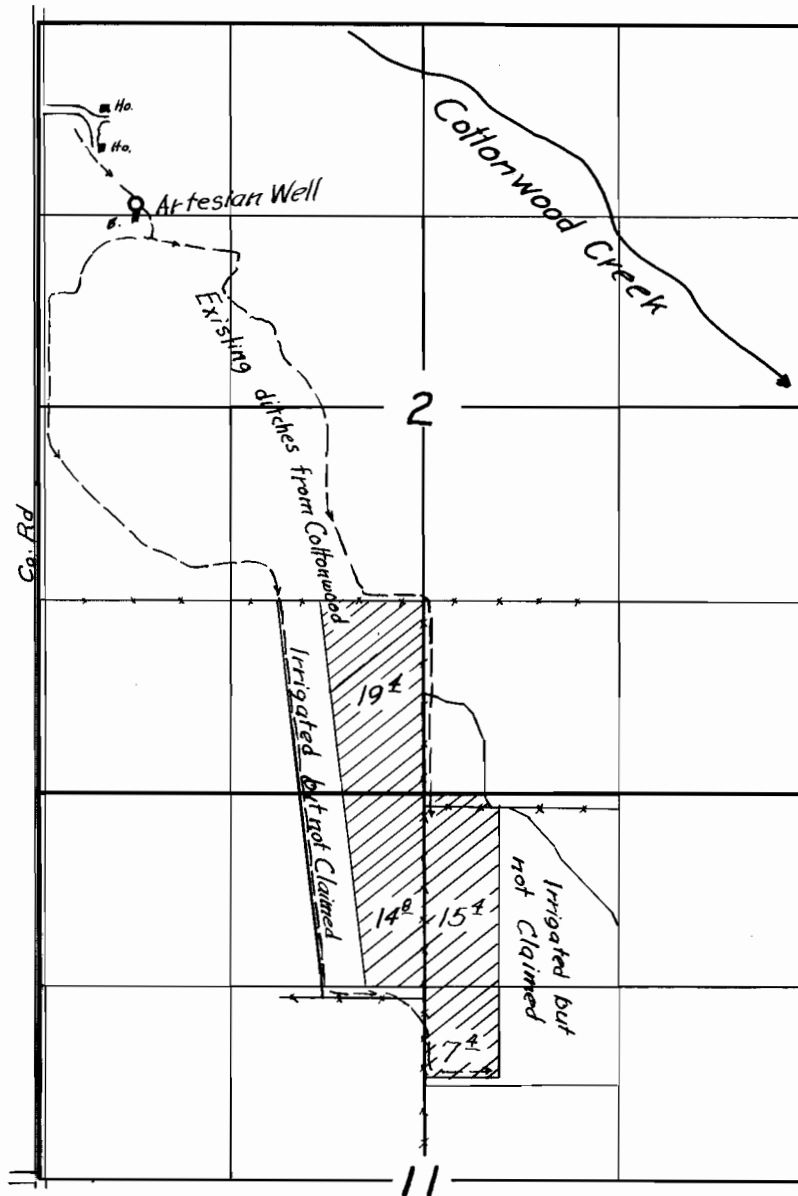

FINAL PROOF SURVEY

UNDER

Application No. U-343 Permit No. U-316
IN NAME OF

FLOYD REED

Surveyed 4 October 1955, by Robert H. Reed