


U-496  
C-24161

# T. 6N. R. 35E. W.M.

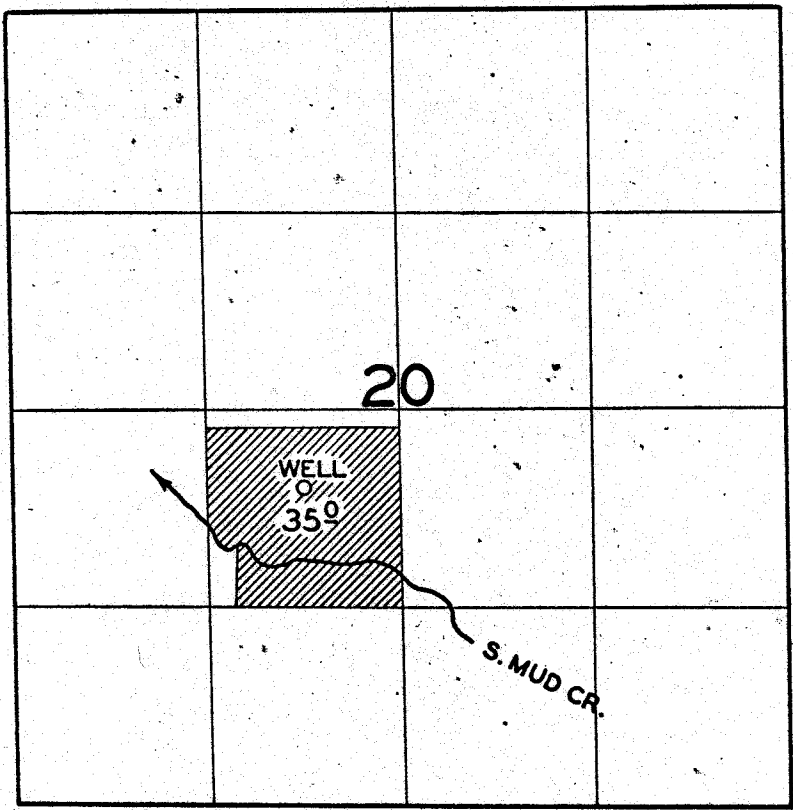

## FINAL PROOF SURVEY UNDER

Application No. U-543 Permit No. U-496  
IN NAME OF

Estate of W.R. Murphy

Surveyed JUNE 4 1957, by C.O. Burtis