


T. 4N. R. 29E. W.M.

SECTION 13

CO. RD.

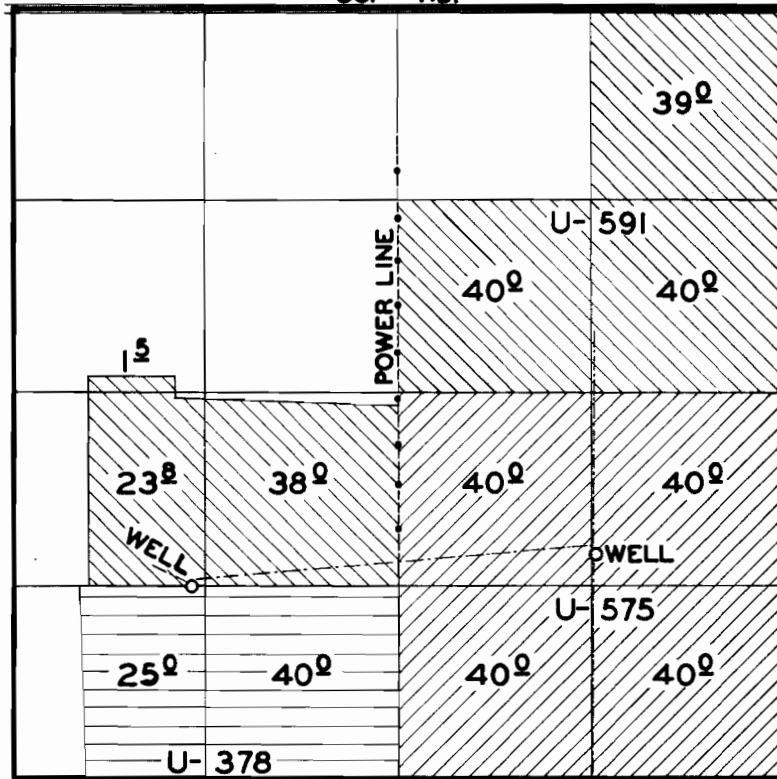

FINAL PROOF SURVEY

Application No. U-643 U-622 U-408 Permit No. U-591 U-575 U-378

IN NAME OF

EDWARDS FARMS INC.

Surveyed MAY 11, 1957, by C.O. Bartels