


T. 6N. R. 35E.W.M.

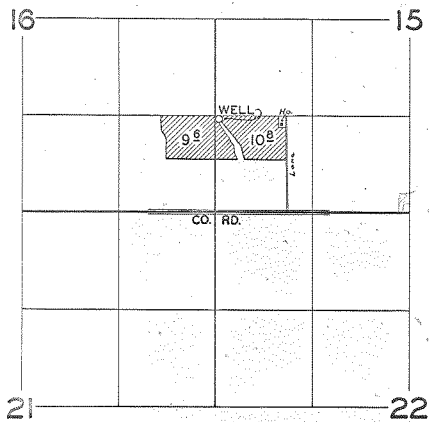

FINAL PROOF SURVEY UNDER

Application No. U-722. Permit No. U-643.
IN NAME OF

E. B. MEISSNER

Surveyed JUNE 1, 1957, by *C. O. Smith*