


-N-

NW⁴ Sec. 29 Tp. 6 N. R. 35.
E. W. M.

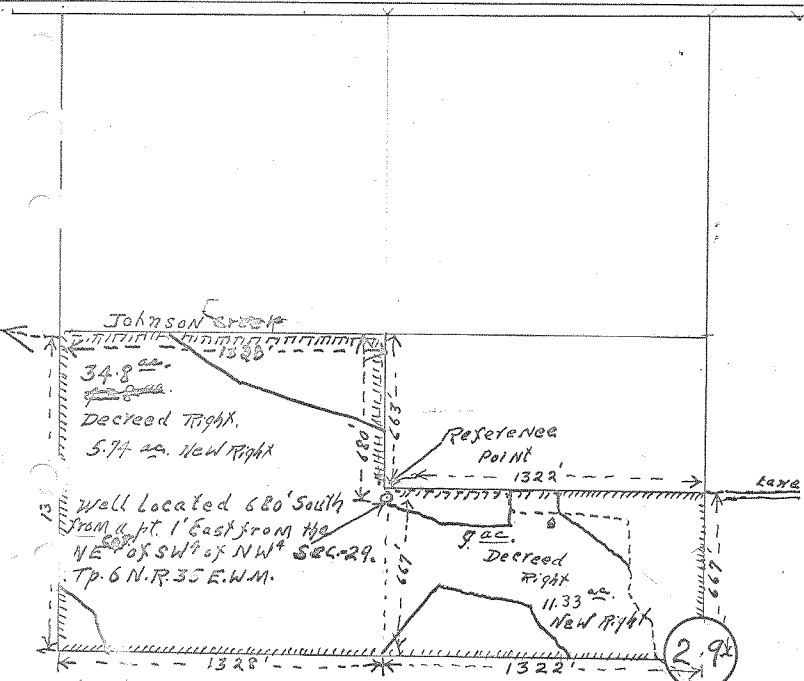

Map to accompany Application of
Ray W. Northrup - for Well Permit
Scale 1" = 400 ft.