


T. 37 S., R. 2 W., W.M.

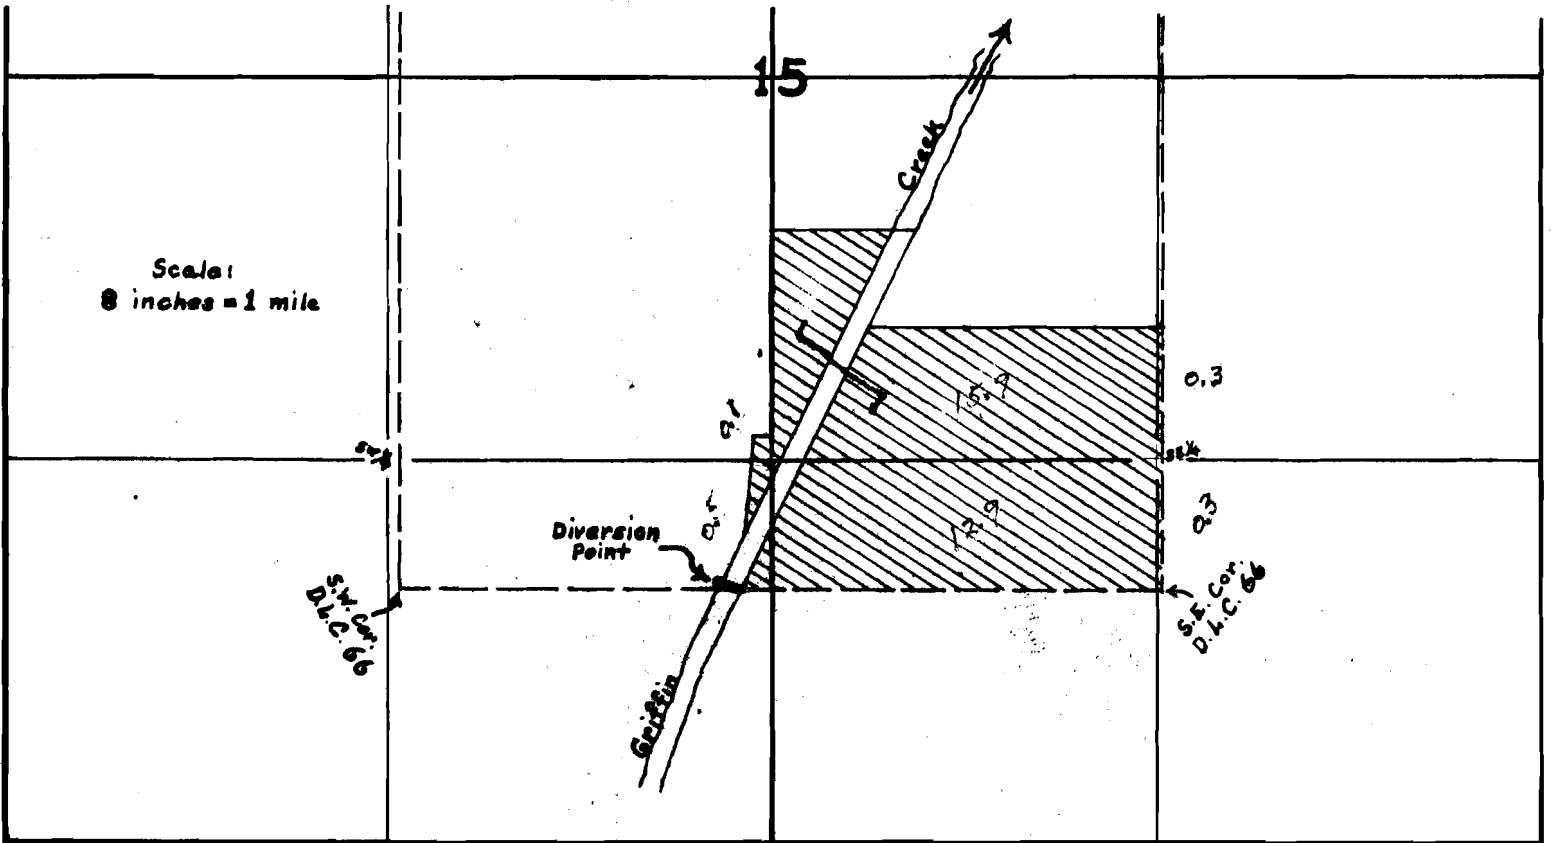

Bert R. Elliott

Sketch showing proposed place of use of 30 acres. -- Find in Regue River Decree page 16 col. 1 in name of H. C. Maury.

David C. Hendrix, W.M.

Transfer No. \_\_\_\_\_