


U-668
2-11-68

T. 2N. R. 33E. W.M.

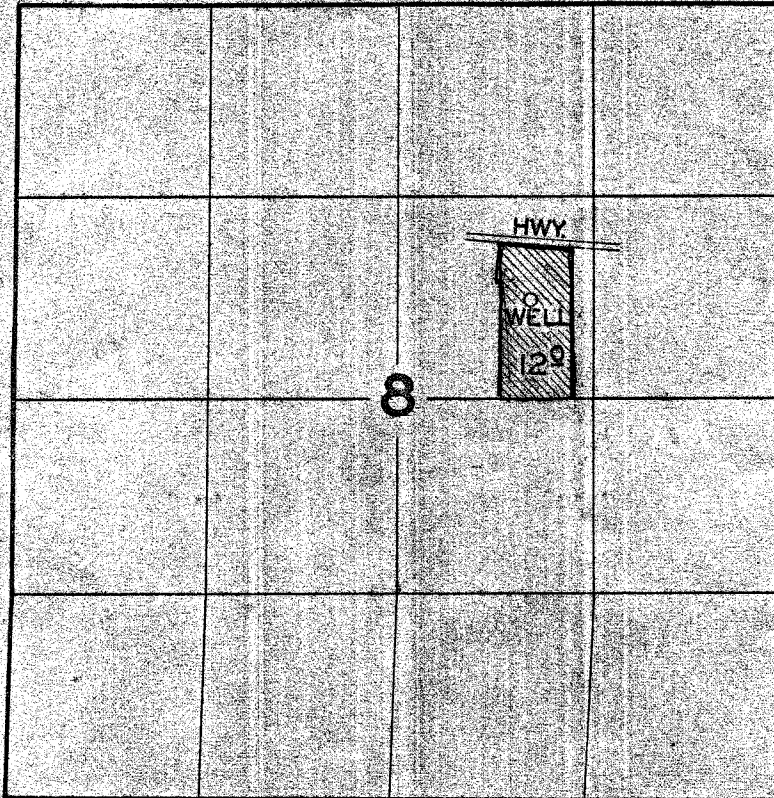

FINAL PROOF SURVEY
UNDER

Application No. U-751 Permit No. U-668
IN NAME OF

HENRY P. SHAFER

Surveyed MAY 29, 1957, by *C. C. Burtels*