


22853

U-708

2469

T. 2N. R. 33E. W.M.

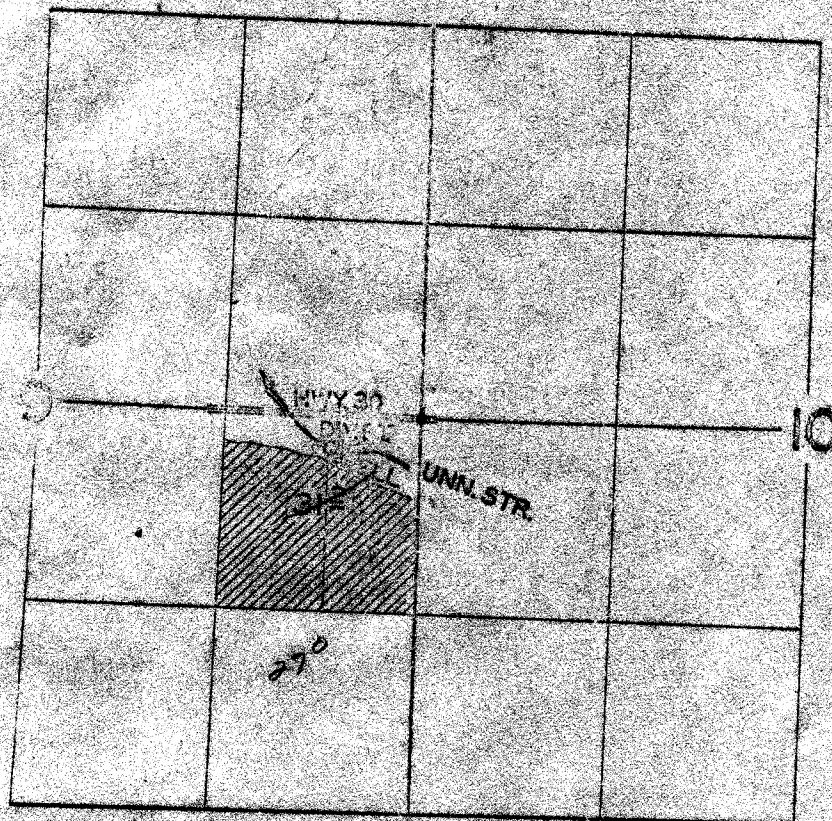

FINAL PLAN OF SURVEY

UNDER

Application No. 29052 Permit No. 22853
U-749 U-708

IN NAME OF

STAMPE

WILBUR L. & AGNES E. JONES

Surveyed MAY 29 1957, by *C. W. Smith*