


# T.6S.R.5W.W.M.

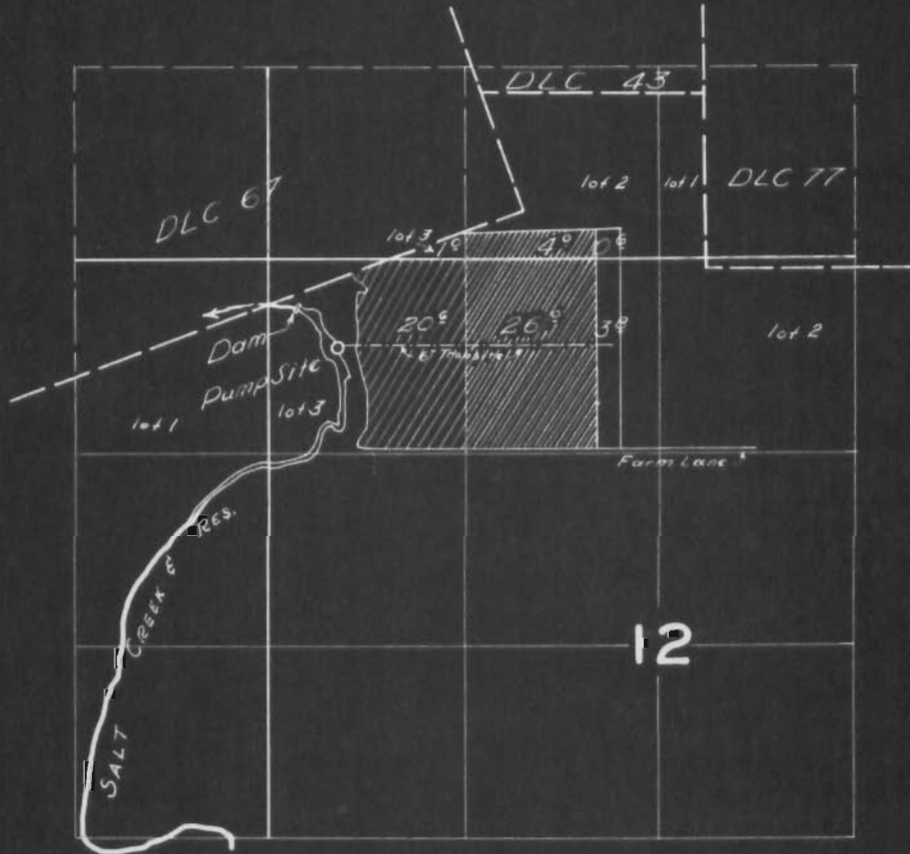

## FINAL PROOF SURVEY

UNDER

24014 & 24013

21570 & R-1390

Application No. 28270

Permit No. 22232



IN NAME OF

JOE. J. DAUENHAUER

Surveyed 4 April 1957, by *Edwin Kelly*