


T.6S.R.5W.W.M.

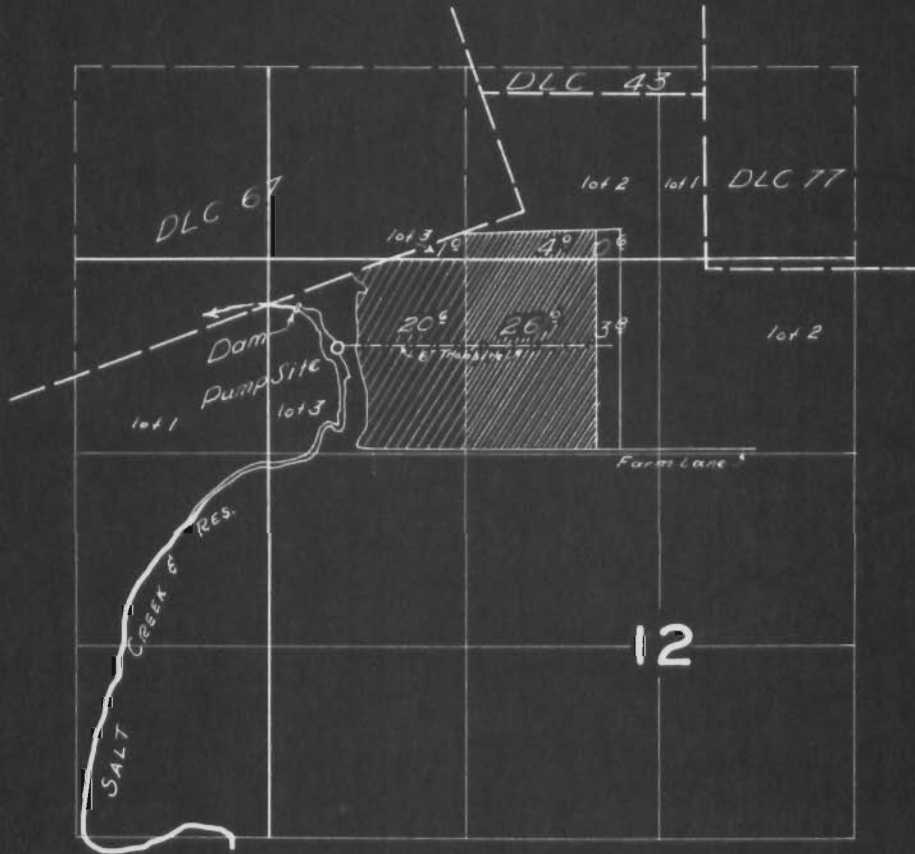

FINAL PROOF SURVEY

UNDER

24014 & 24013

21570 & R-1390

Application No. 28270 Permit No. 22252



IN NAME OF

JOE. J. DAUENHAUER

Surveyed 4 April 1957, by *[Signature]*