
T.6S.R.5W.W.M.

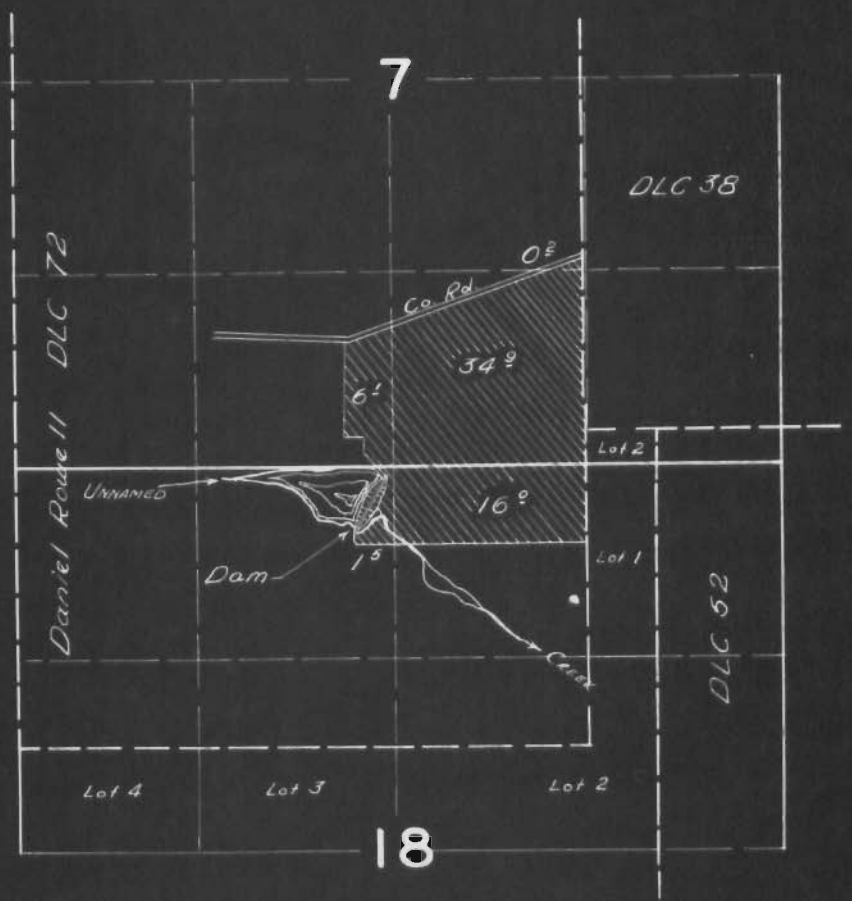

FINAL PROOF SURVEY

UNDER

R-28434 R-1538

Application No. 28435 Permit No. 22489


IN NAME OF

JACK DE JONG

Surveyed 5 April 1957, by G. Hewitt

DFP-2P-144

T.6S.R.5W.W.M.

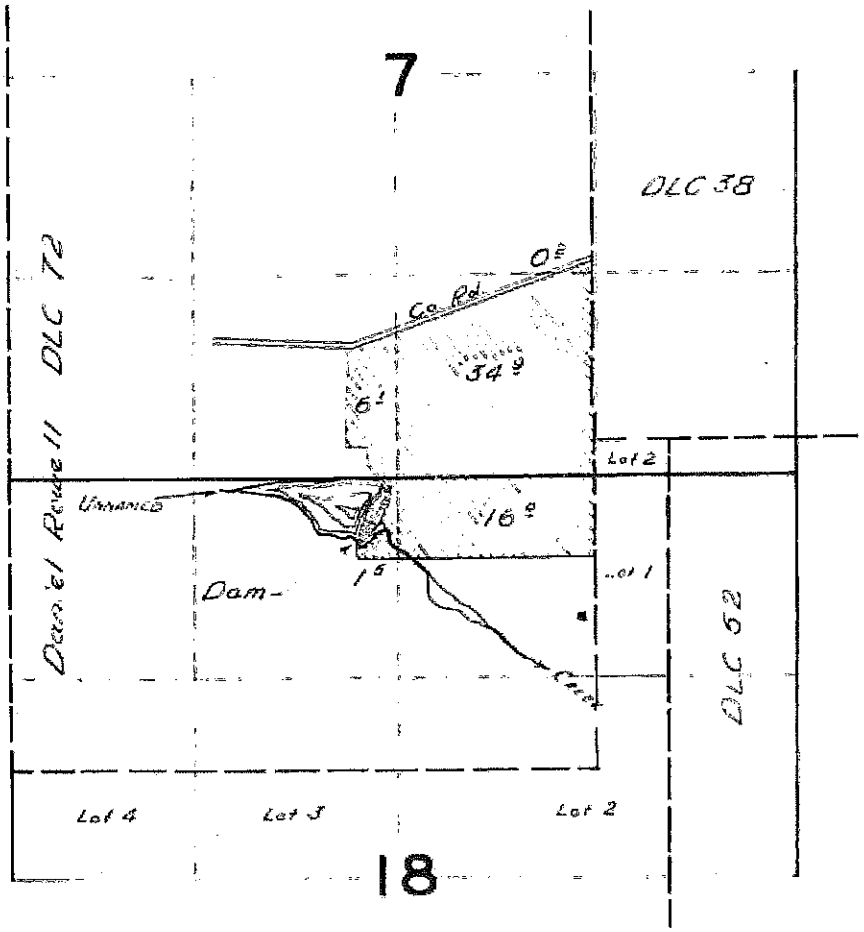

R-28434
28435

R-1578
22489

JACK DE JONG

5 April 57