


T.6S.R.5W.W.M.

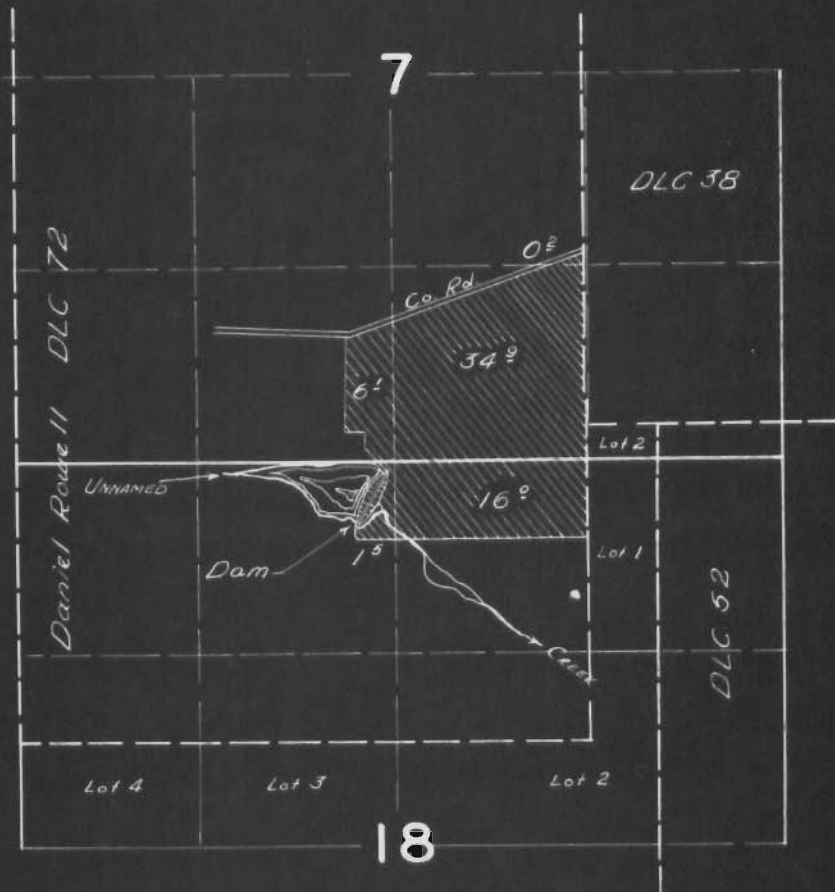

FINAL PROOF SURVEY

UNDER

R-28434

R-1538

Application No. 28435

Permit No. 22489

IN NAME OF

JACK DE JONG

Surveyed 5 April 1957, by *A. Prohaska*