


T9WRIEWM

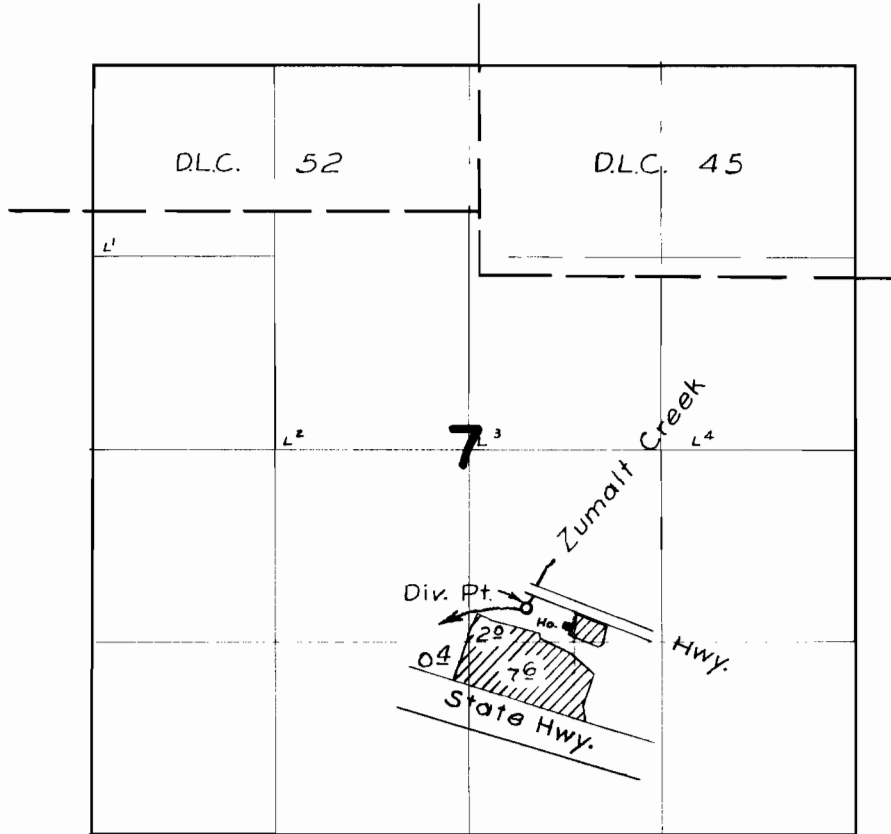

FINAL PROOF SURVEY UNDER

Application No. 20186 Permit No. 15803...
IN NAME OF

Gordon Strickland

Surveyed Aug. 26 1957, by *M. Beech*