


T. 16S. R. 23E. W.M.

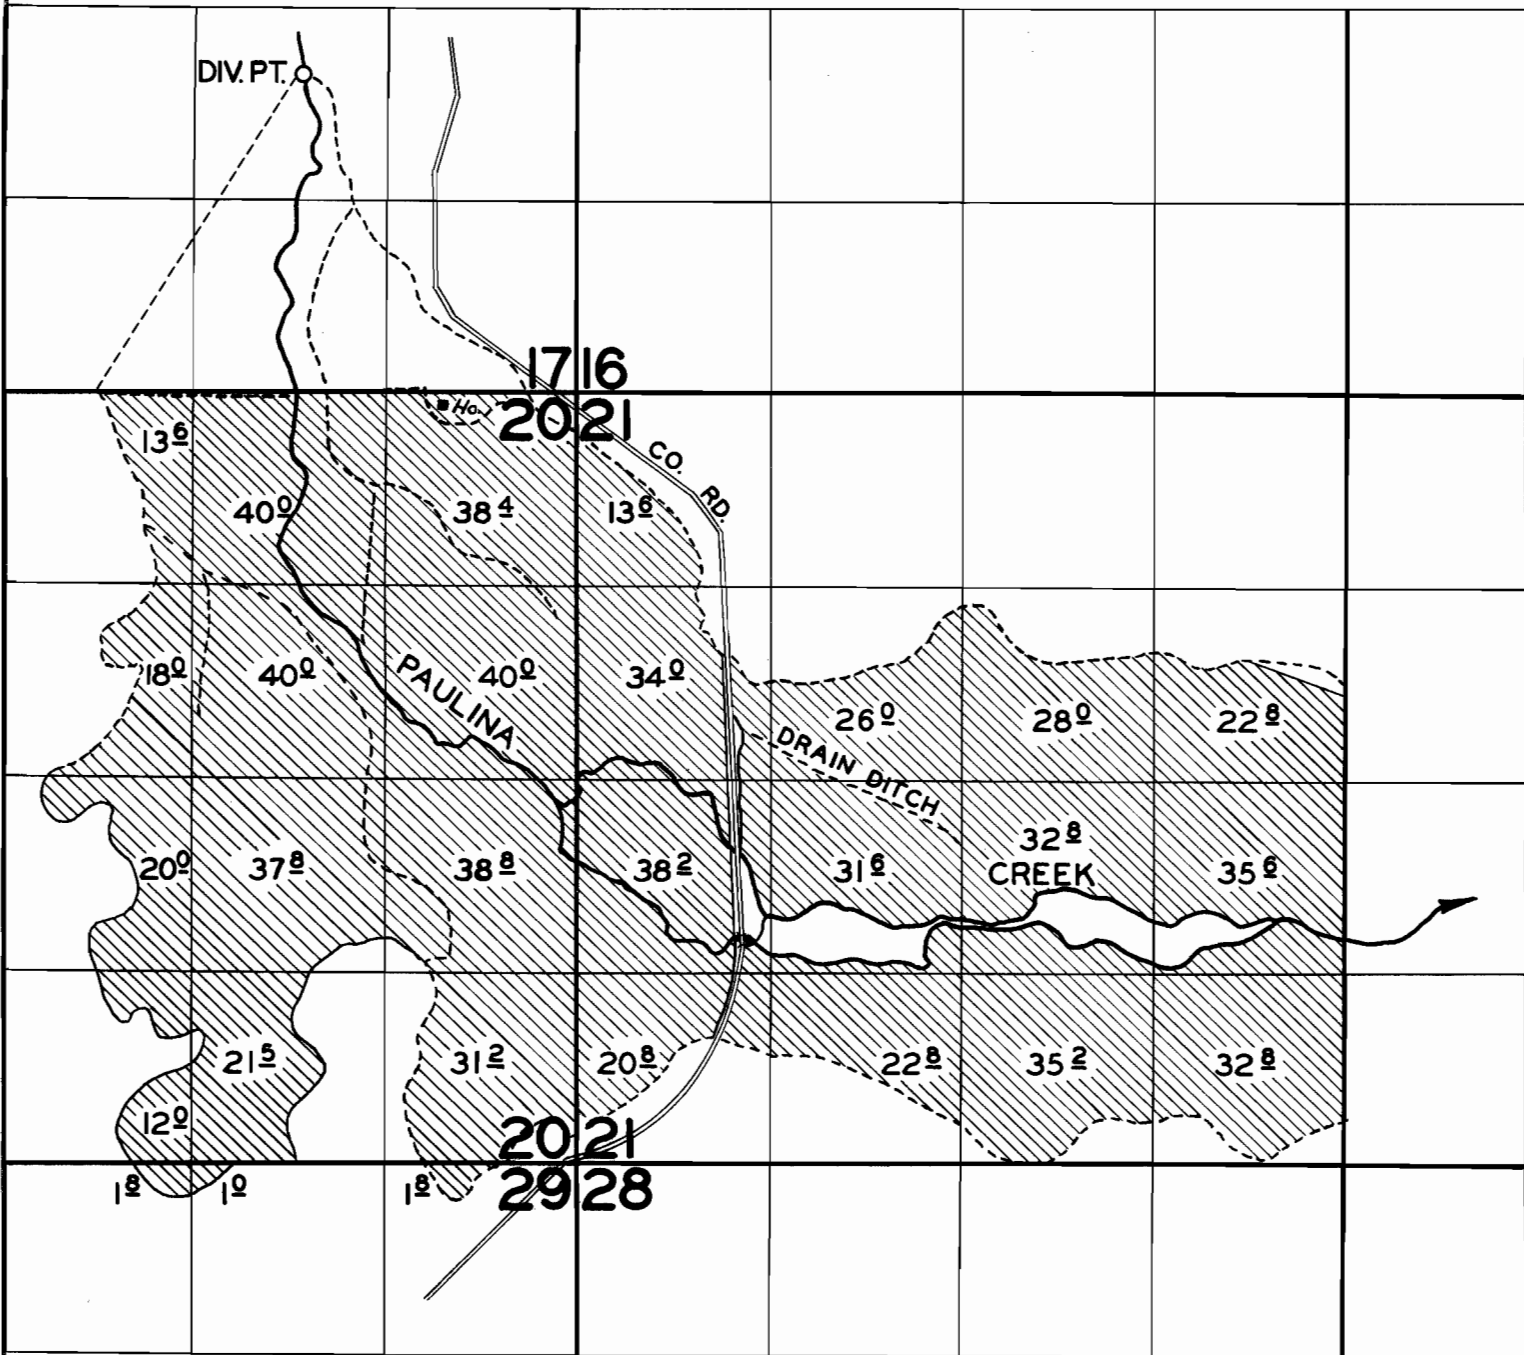

FINAL PROOF SURVEY

UNDER

Application No. 18486 Permit No. 14085

IN NAME OF

E. N. FEARRIEN

Surveyed AUG. 6. 1957, by *C. O. Bartel*