


T.17S.R.6W.W.M.

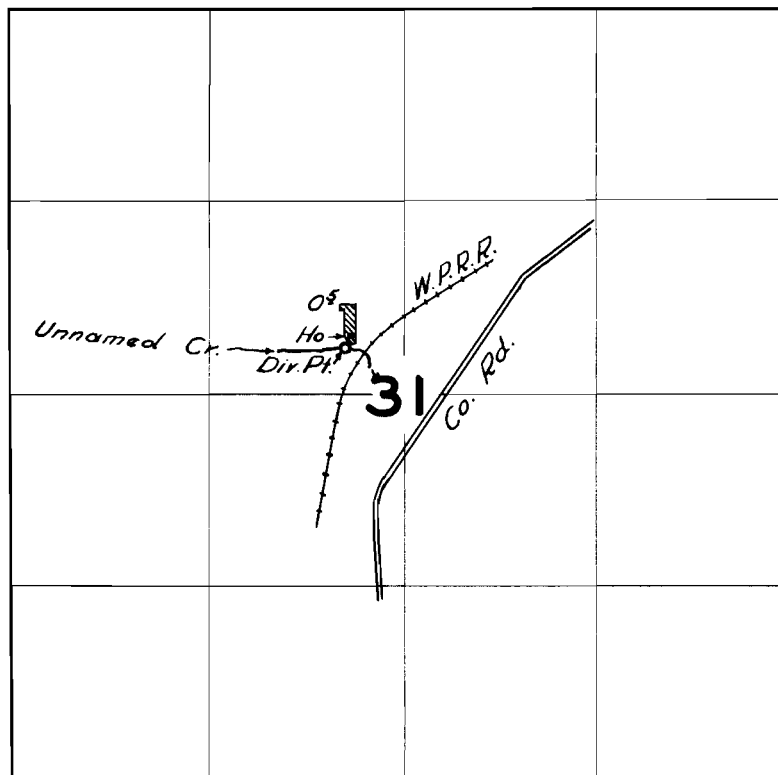

FINAL PROOF SURVEY
UNDER

Application No. 20515 Permit No. 16017

IN NAME OF

STEPHEN H. REYNOLDS

Surveyed 3 May 1957, by Calvin R. R. R.