


T.12S.R.6W.W.M.

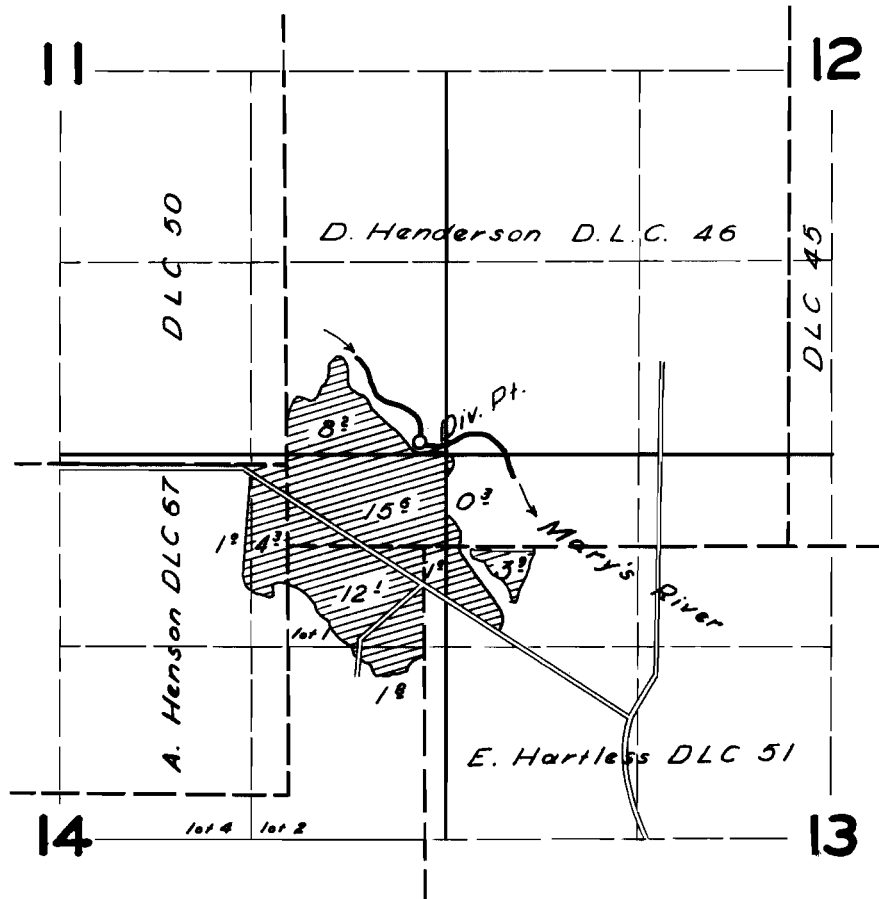

**FINAL PROOF SURVEY**  
UNDER

Application No. 20627 Permit No. 16137  
IN NAME OF

Dorval & Arma Bevans

Surveyed 20 Aug. 1957, by [Signature]