


# T.13S.R.10W.W.M.

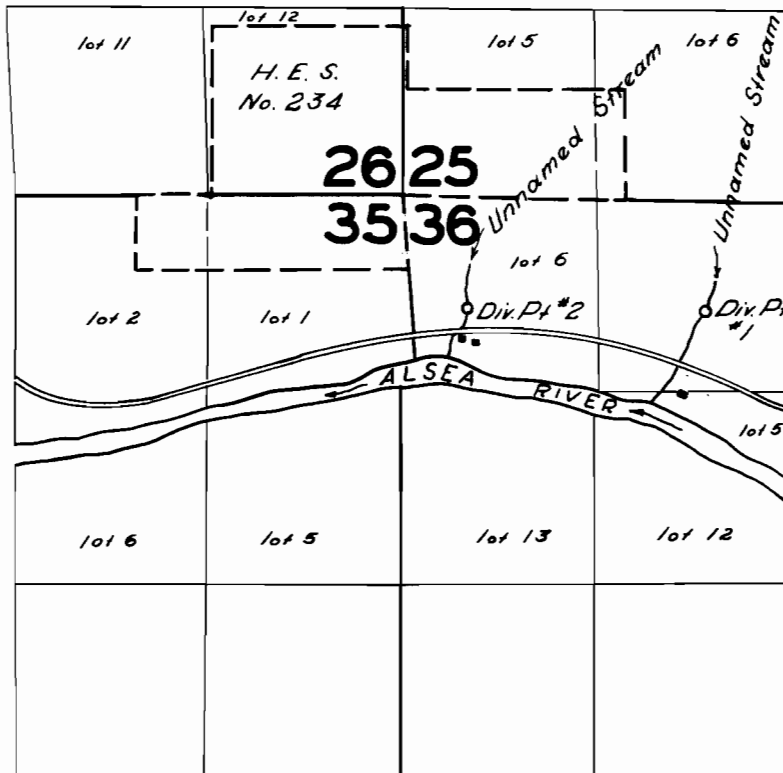

## FINAL PROOF SURVEY UNDER

Application No. 20707 Permit No. 16225

IN NAME OF

R. C. LOUDENBECK

Surveyed 17 June 1957, by R. H. Hilly