


T. 3S. R. 9W.W.M.

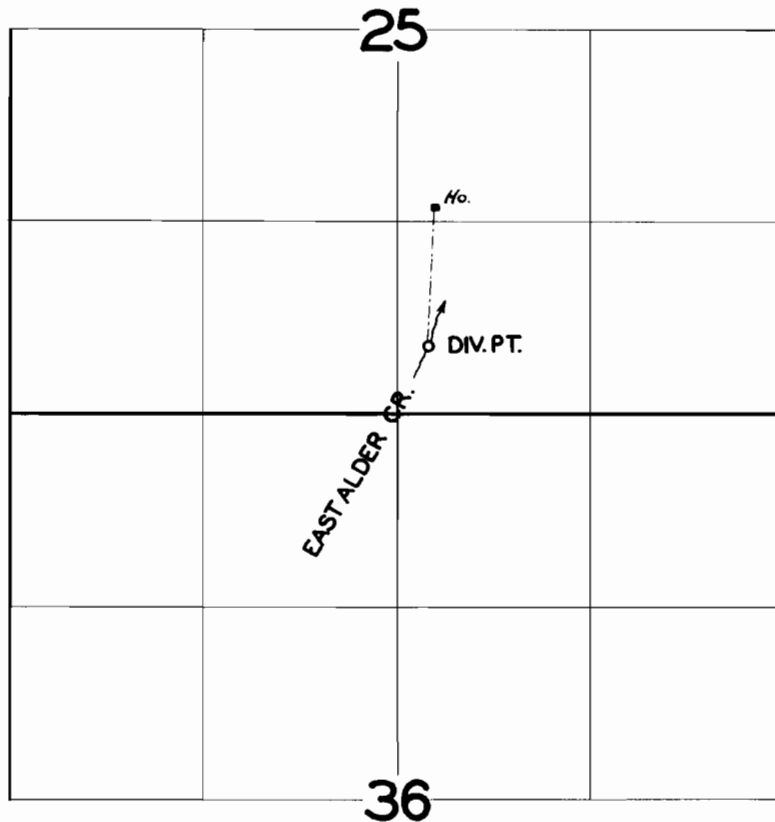

FINAL PROOF SURVEY
UNDER

Application No. 21660 Permit No. 17012
IN NAME OF

HL. JONES

Surveyed AUG. 9 1957, by *Arthur P. [Signature]*