


T. 30S. R. 2W. W.M.

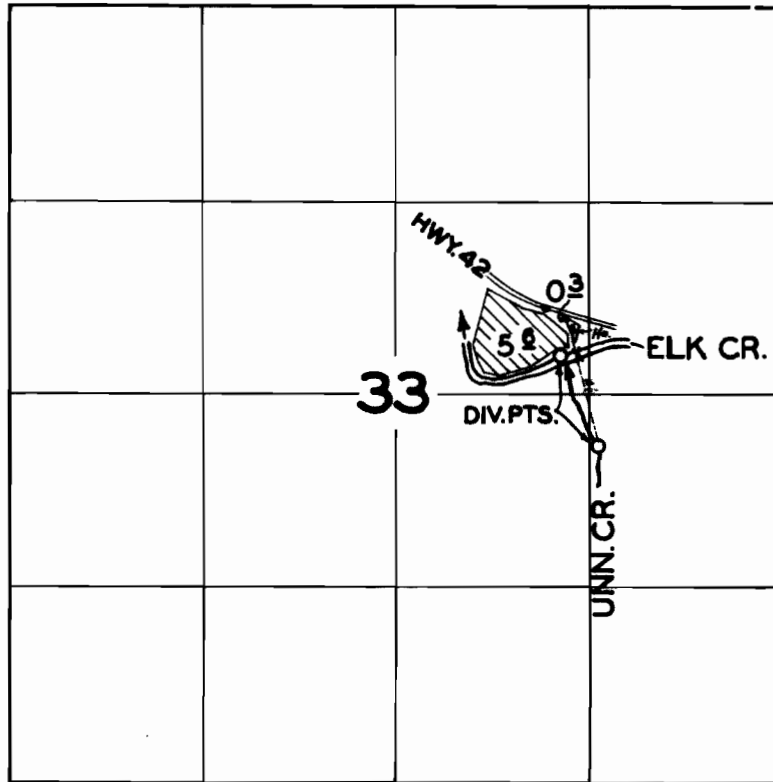

FINAL PROOF SURVEY
UNDER

Application No. 21679 21680 Permit No. 17023 17024
IN NAME OF

ERNEST DAHACK

Surveyed MAY 22, 1950 by H.L. COFFMAN