


T.28S.R.7W.W.M.

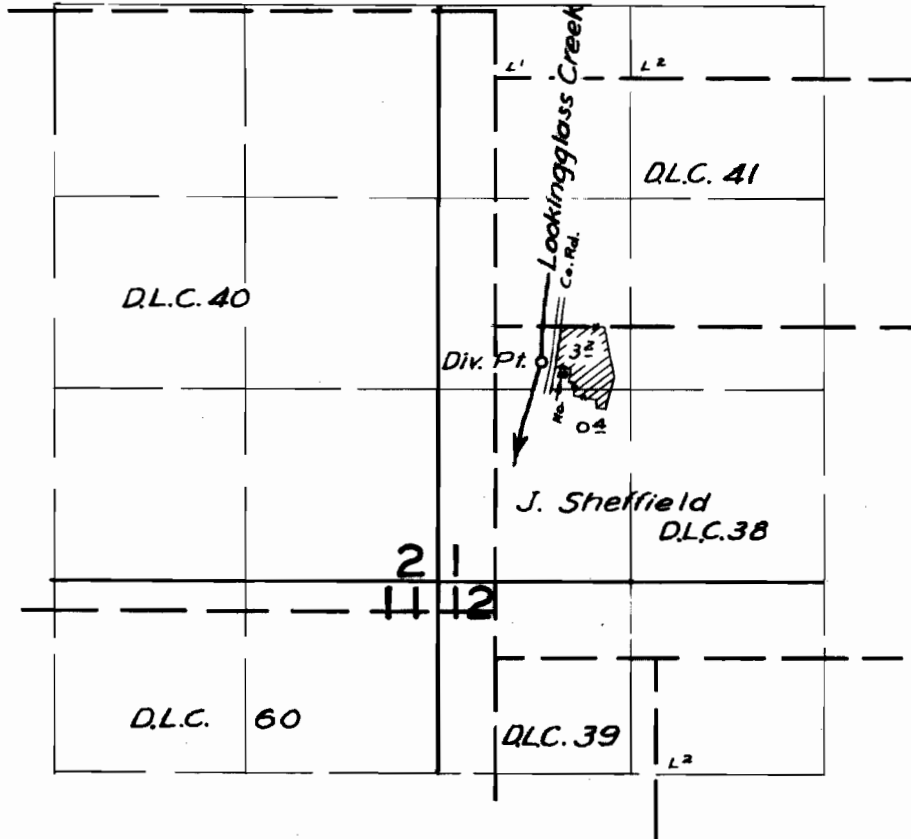

FINAL PROOF SURVEY
UNDER

Application No. 22119 Permit No. 17425
IN NAME OF

Raymond Buell

Surveyed July 19 1957, by M. Bish