


T.16 S.R.4 E.W.M.

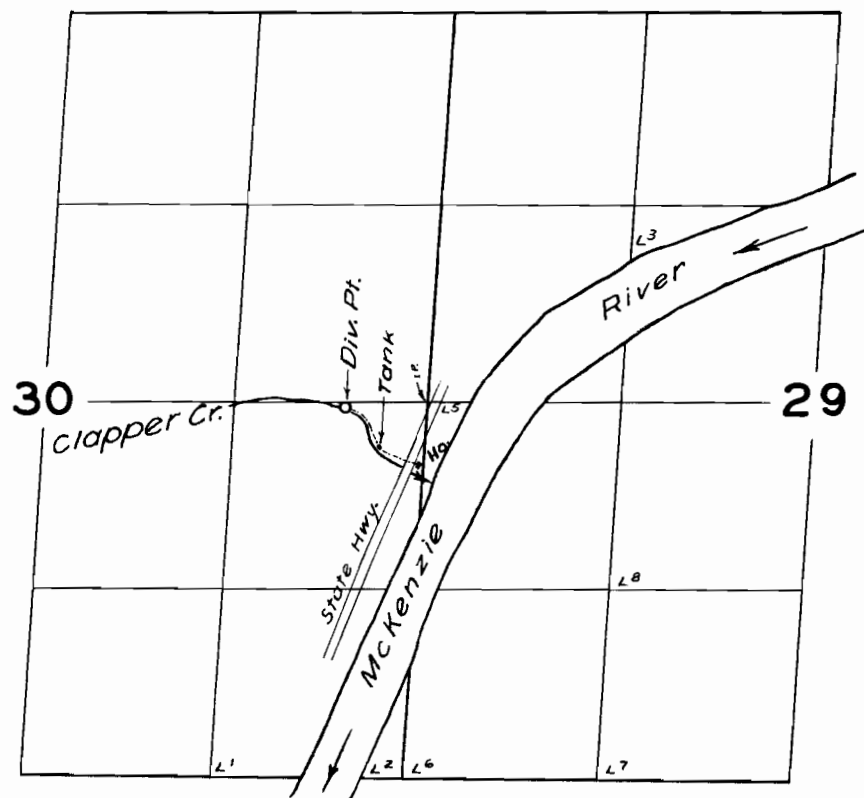

FINAL PROOF SURVEY
UNDER

Application No. 22318 Permit No. 17597
IN NAME OF

Arthur S. Dustan

Surveyed June 28 1957, by M. Bish