


T.23S.R.4W.W.M.

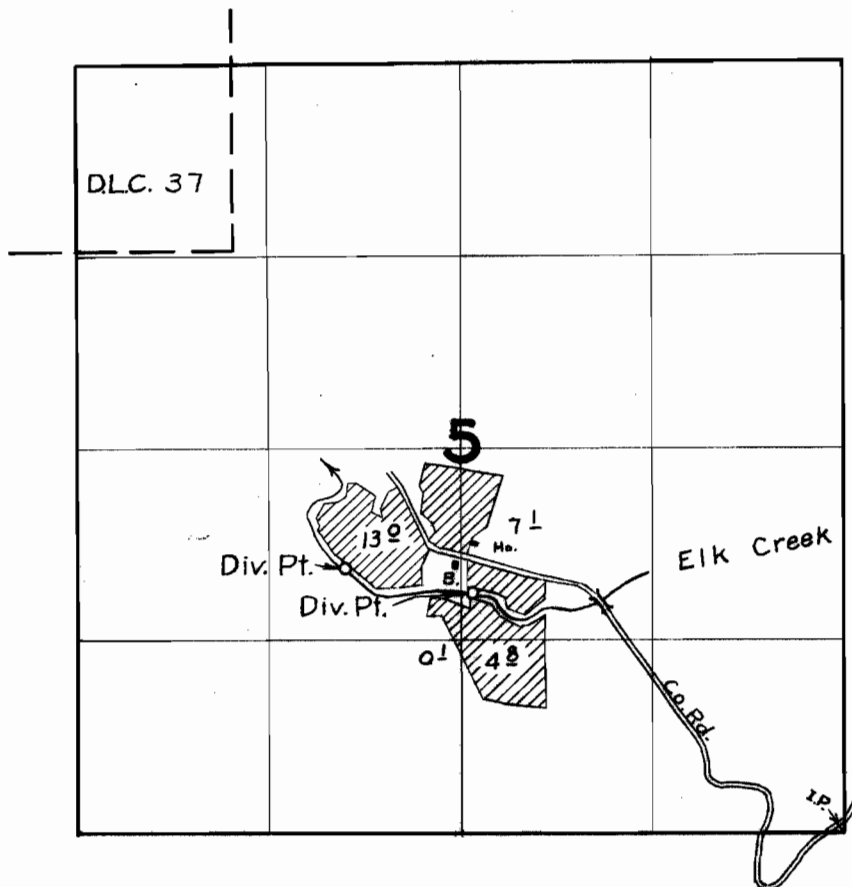

FINAL PROOF SURVEY
UNDER

Application No. 22567 Permit No. 17762
IN NAME OF

H.T. Paselk

Surveyed Sept. 11, 1957, by M. B. B.