


T.9S.R.5W.W.M.

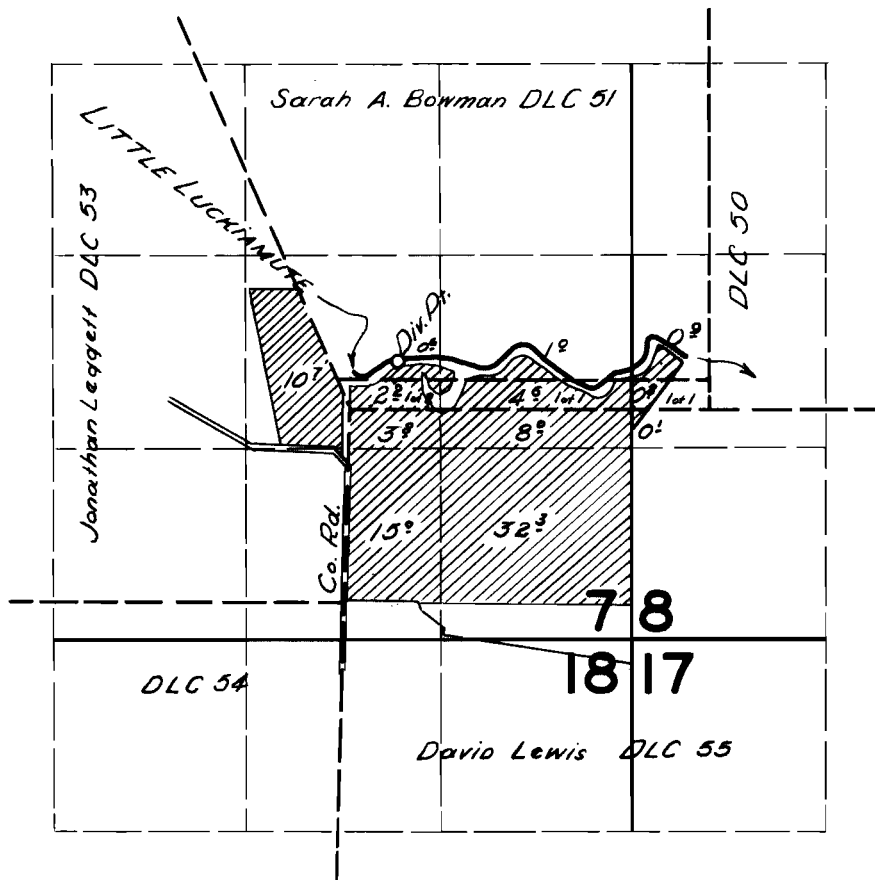

FINAL PROOF SURVEY

UNDER

Application No. 23081 Permit No. 18407

IN NAME OF

CHET HEALY

Surveyed 28 Mar. 1957, by [Signature]