


T.9S.R.5W.W.M.

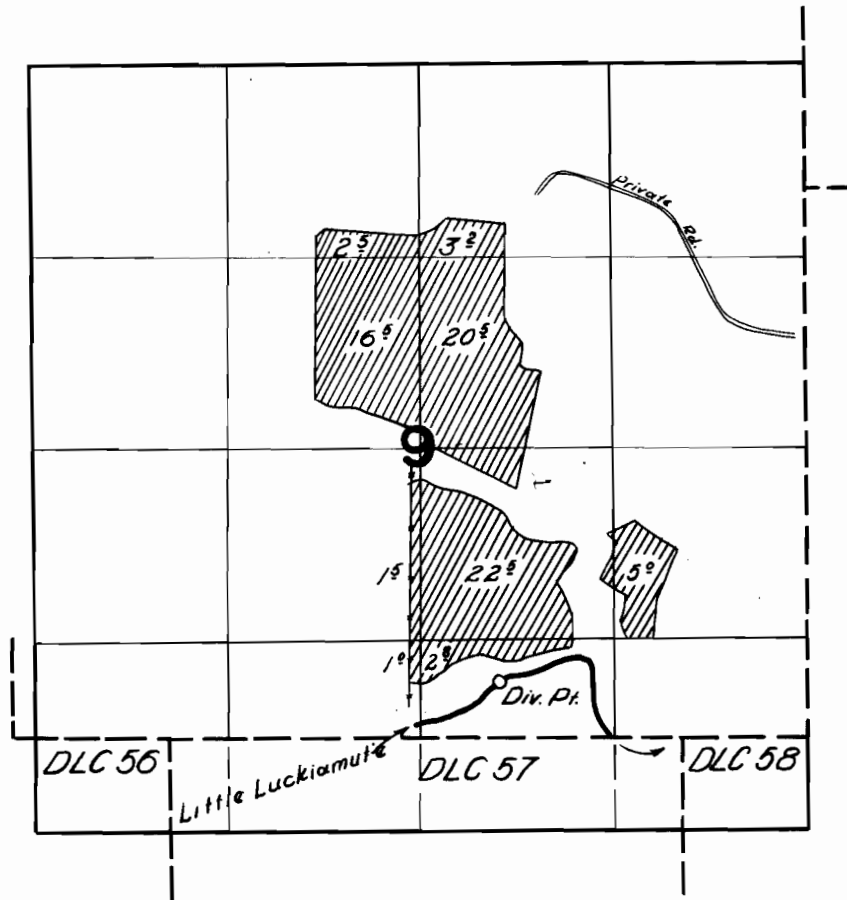

FINAL PROOF SURVEY
UNDER

Application No. 23438 Permit No. 18500

IN NAME OF

HOWARD V. MORGAN

Surveyed 28 Mar. 1957, by R. W. Kitchy