


T.9S.R.5W.W.M.

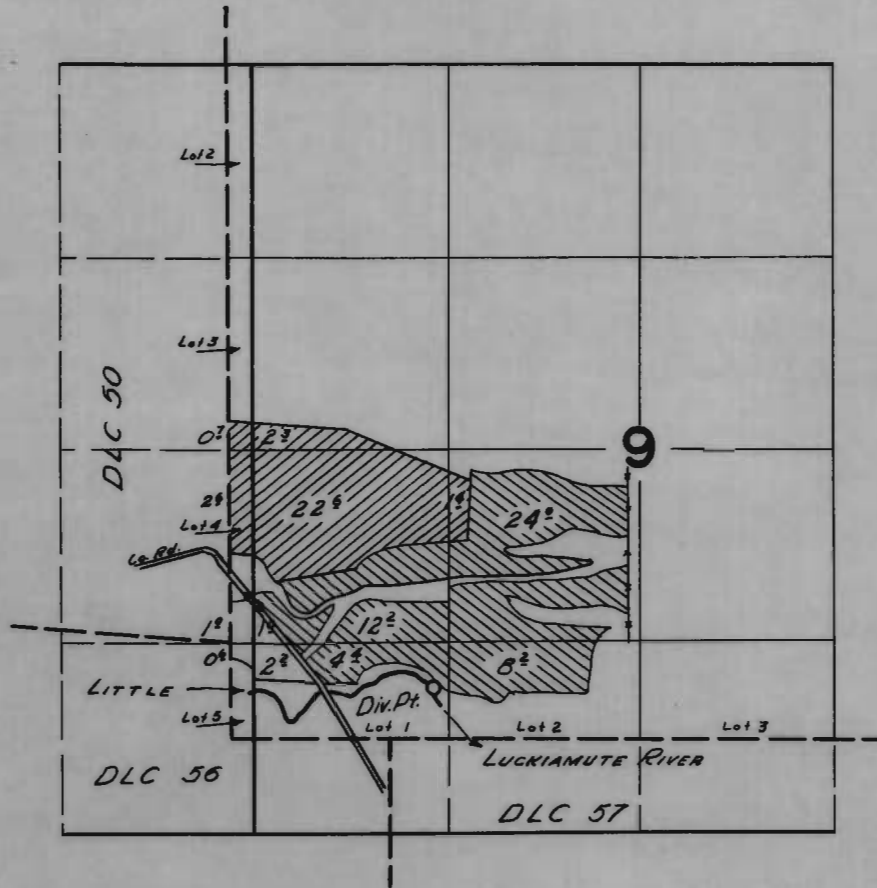

FINAL PROOF SURVEY

UNDER

23544

18590

Application No. 31057

Permit No. 24422

IN NAME OF

CLARE R. MILLHOUSER

16 Aug 1956

Surveyed 27 Mar 1957, by

*[Handwritten Signature]*