


T. 4N. R. 28E.W.M.

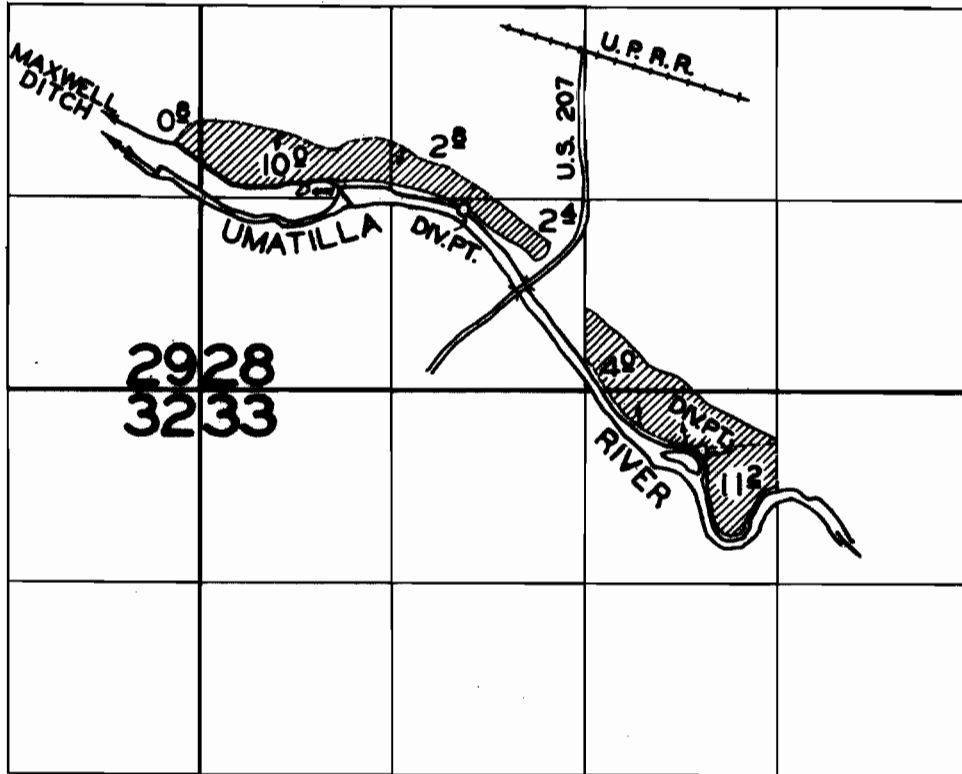

**FINAL PROOF SURVEY**  
UNDER

Application No. 23672 Permit No. 18659  
IN NAME OF

Ernest Dumond

Surveyed MAY 16 1957, by C.O. Bailets