


T. 31S. R. 2W. W.M.

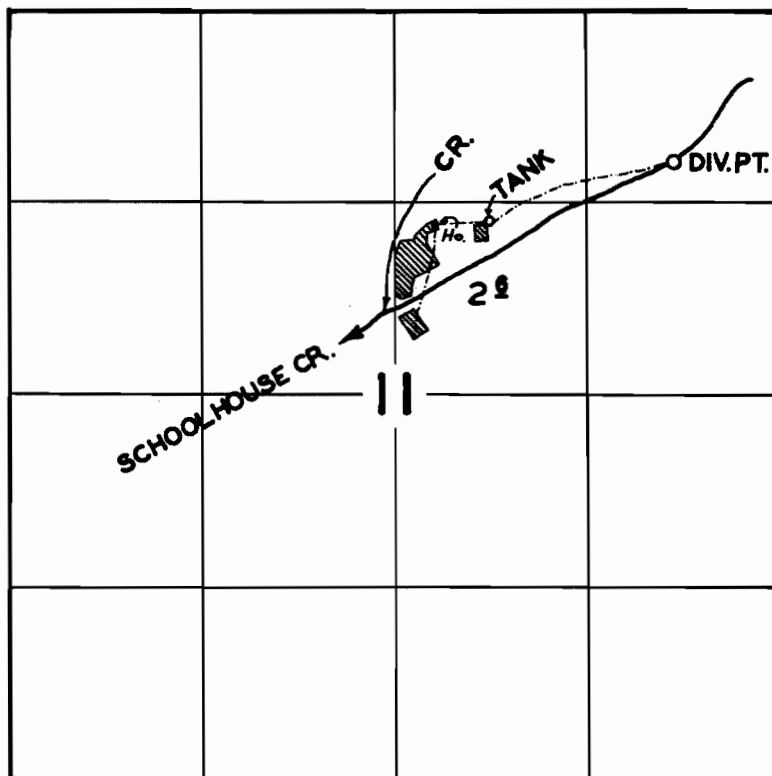

FINAL PROOF SURVEY
UNDER

Application No. 23784 Permit No. 18764
IN NAME OF

IRA FRANKLIN BARROW

Surveyed JULY 27 1957, by M. Rich