T.9 S.R.1 E.W.M.

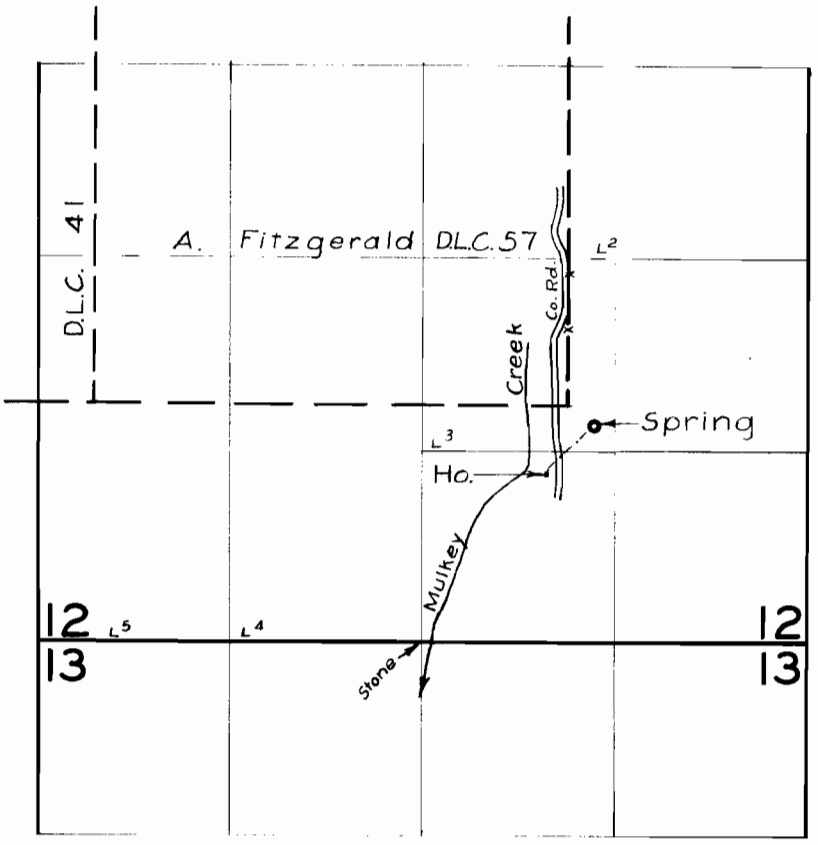

FINAL PROOF SURVEY
UNDER

Application No. 23681 Permit No. 18806
IN NAME OF

John Lambrecht

Surveyed Aug. 29 1957, by M. Bish

1957-C