


T.27 S.R.4 W.W.M.

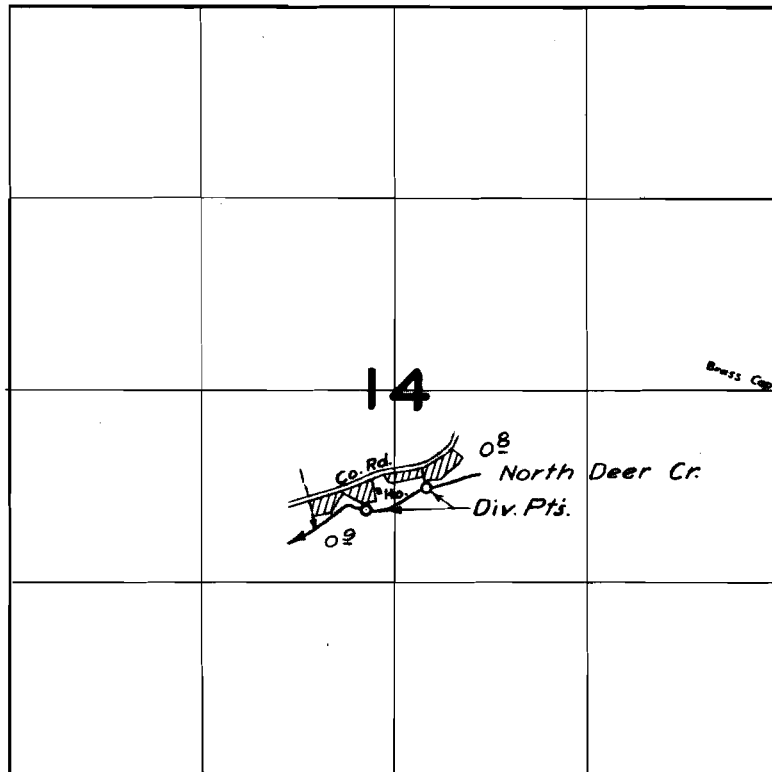

FINAL PROOF SURVEY  
UNDER

Application No. 23896 Permit No. 18897  
IN NAME OF

Justin W. Eifert

Surveyed July 15 1957, by Tr. Bish