


T.II.S.R.I W.W.M.

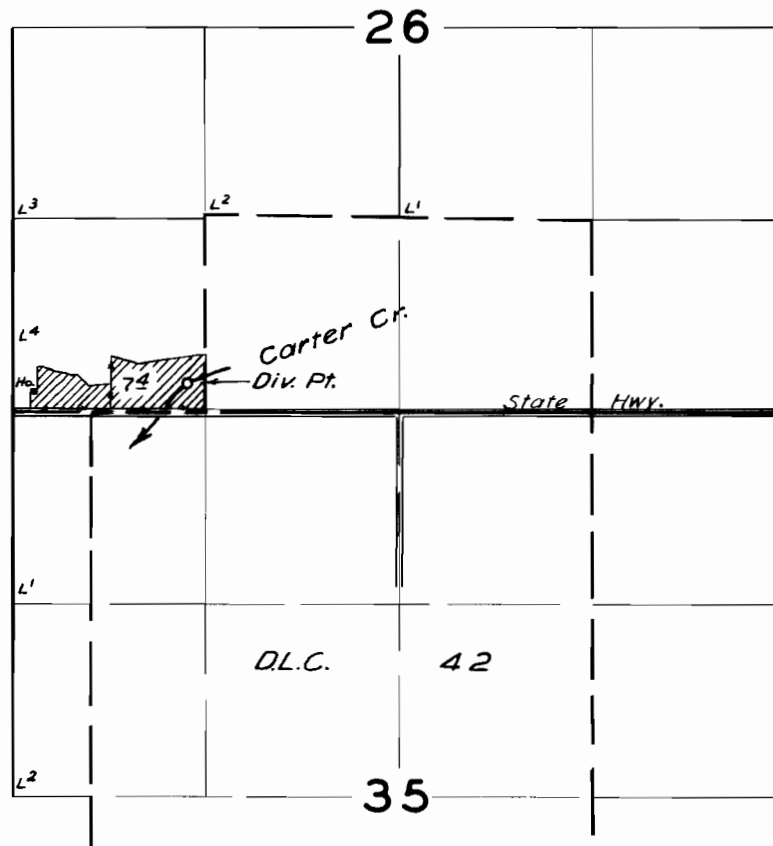

FINAL PROOF SURVEY UNDER

Application No. 24096 Permit No. 18974
IN NAME OF

Clifford & J.E. Mork

Surveyed June 7, 1957, by m. Rich