


T.16 S.R.2 E.W.M.

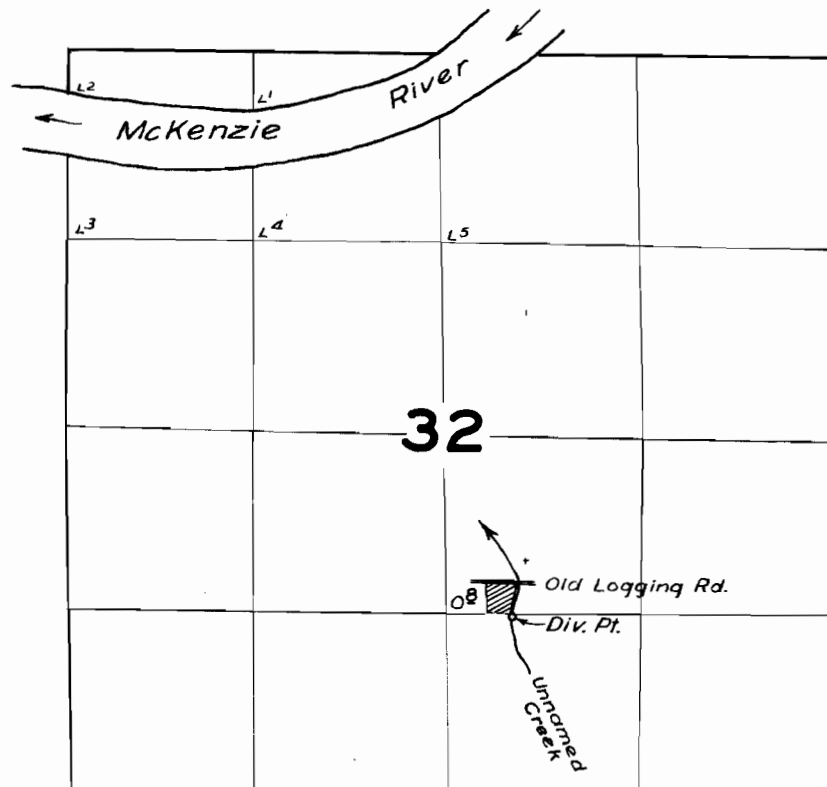

FINAL PROOF SURVEY
UNDER

Application No. 24279 Permit No. 19049
IN NAME OF

Rube Montgomery

Surveyed June 27, 1957, by M. B. Bish