


T.9S.R.2E.W.M.

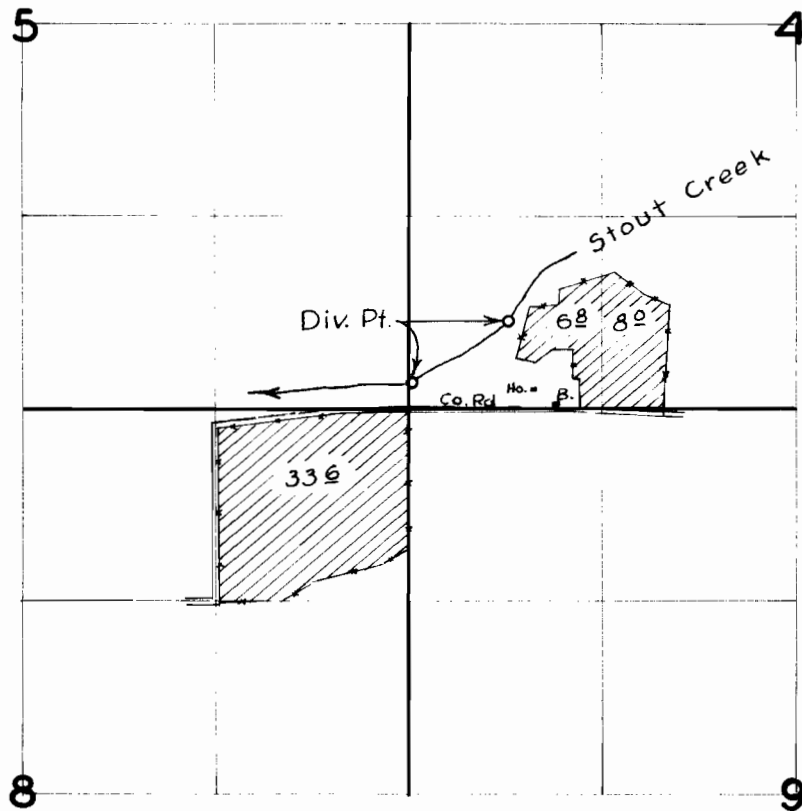

FINAL PROOF SURVEY
UNDER

Application No. 24007 Permit No. 19334
IN NAME OF

Leo Wagner

Surveyed 10 Oct. 1957, by M. Bish