


T.10 S.R.1 E.W.M.

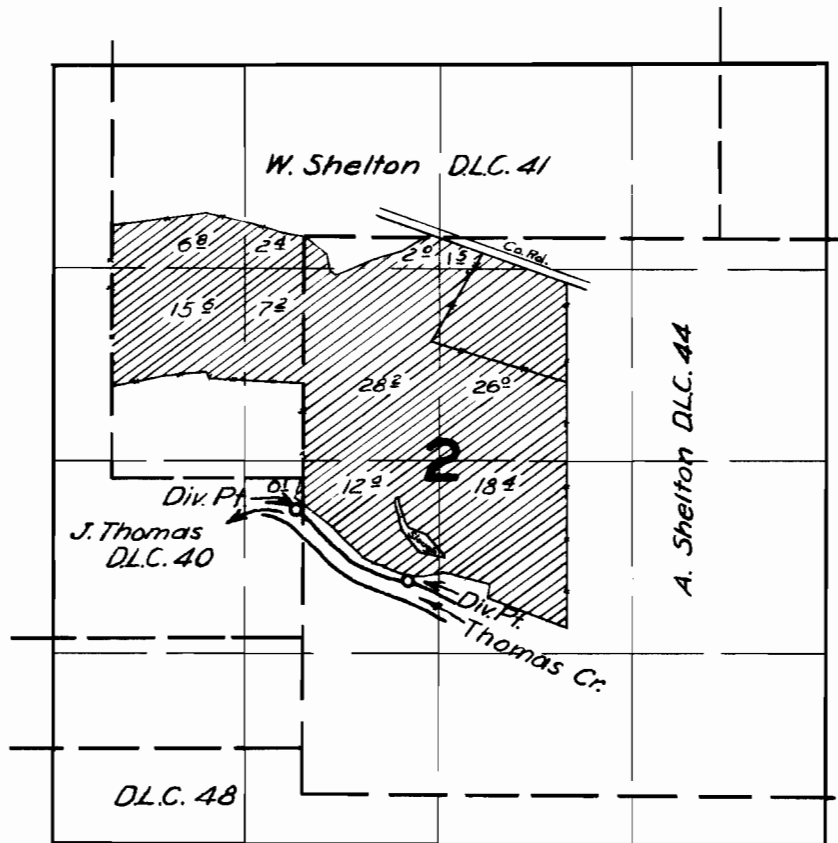

FINAL PROOF SURVEY
UNDER

Application No. 24679 Permit No. 19411
IN NAME OF

William A. Lulay

Surveyed May 27 1957, by M. Bish