


T. 4S. R. 10W. W.M.

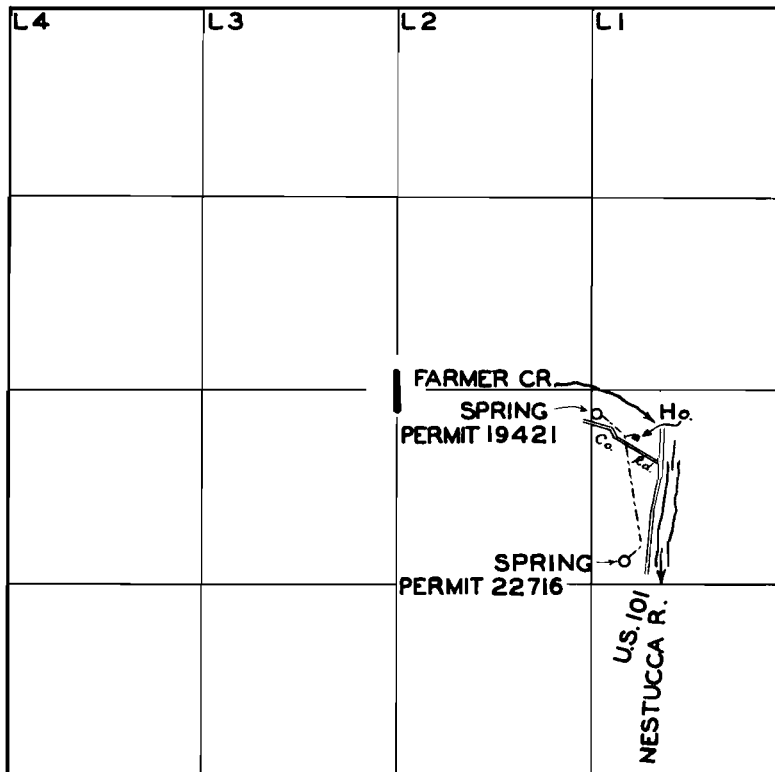

FINAL PROOF SURVEY  
UNDER

24716                      19421  
Application No. 28892 Permit No. 22716  
IN NAME OF

FRANK L. FARMER

Surveyed AUG. 8 1957, by *[Signature]*