


# T.19S.R.1W.W.M.

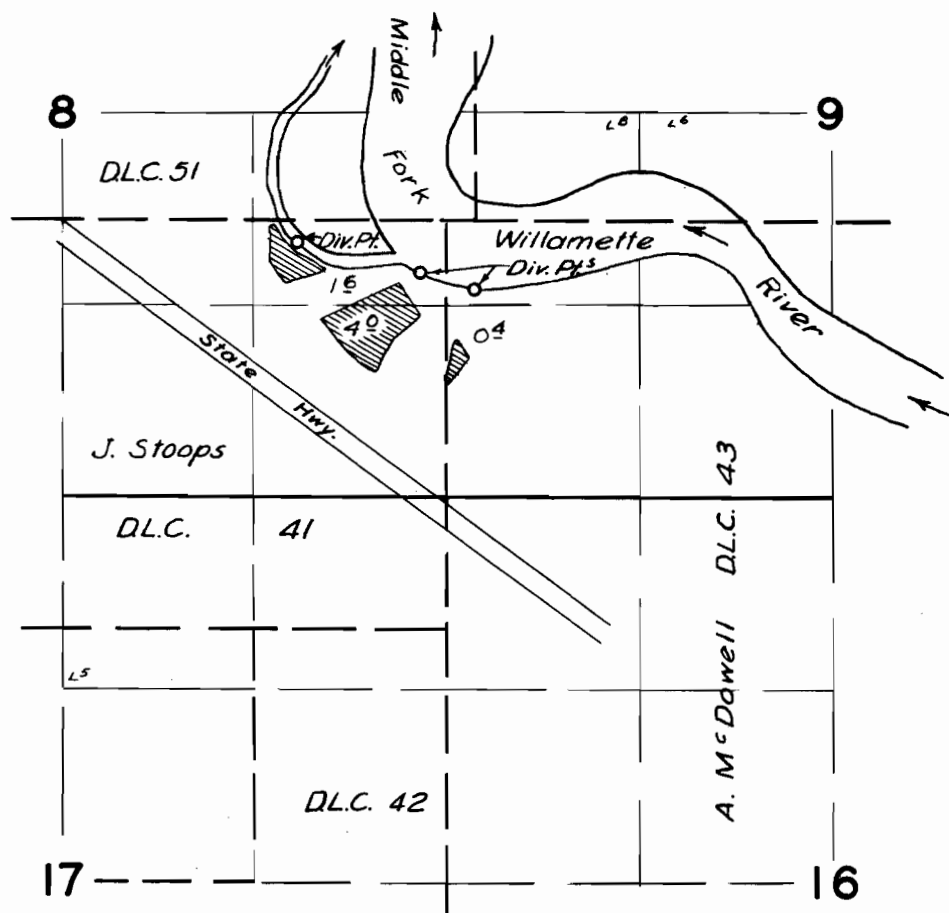

## FINAL PROOF SURVEY

UNDER

Application No. 24356. Permit No. 19449.

IN NAME OF

*John E. & Elinor Hoole & Sigvart & Leonore Ellingson*

Surveyed *June 19 1957*, by *M. Bish*.....