


T. 12S. R. 6W. W.M.

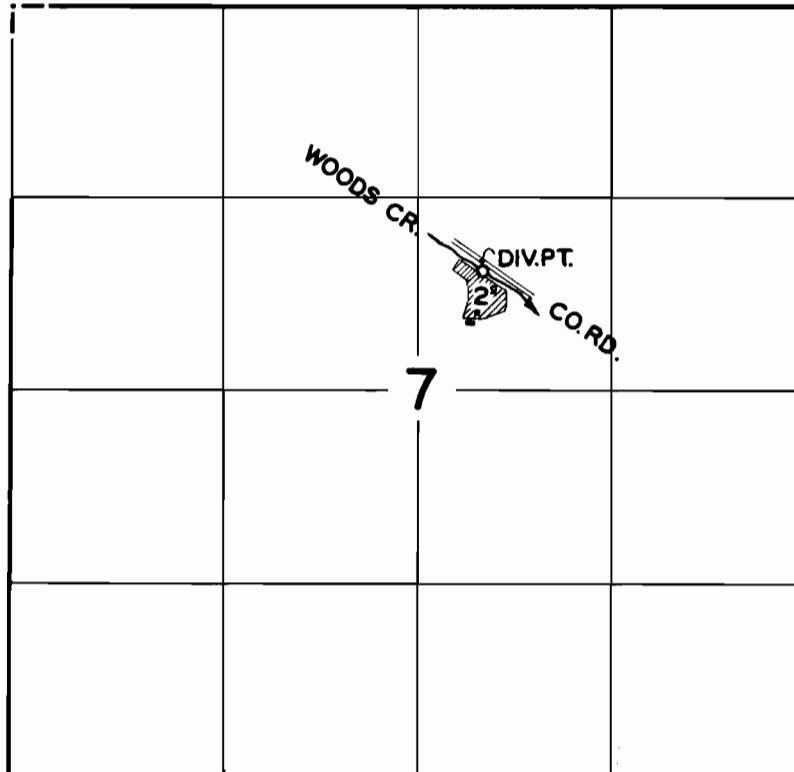

FINAL PROOF SURVEY
UNDER

Application No. 24820 Permit No. 19545
IN NAME OF

N.C. JENSEN JR.

Surveyed AUG. 21, 1957, by *[Signature]*