


T.9S.R.2 E.W.M.

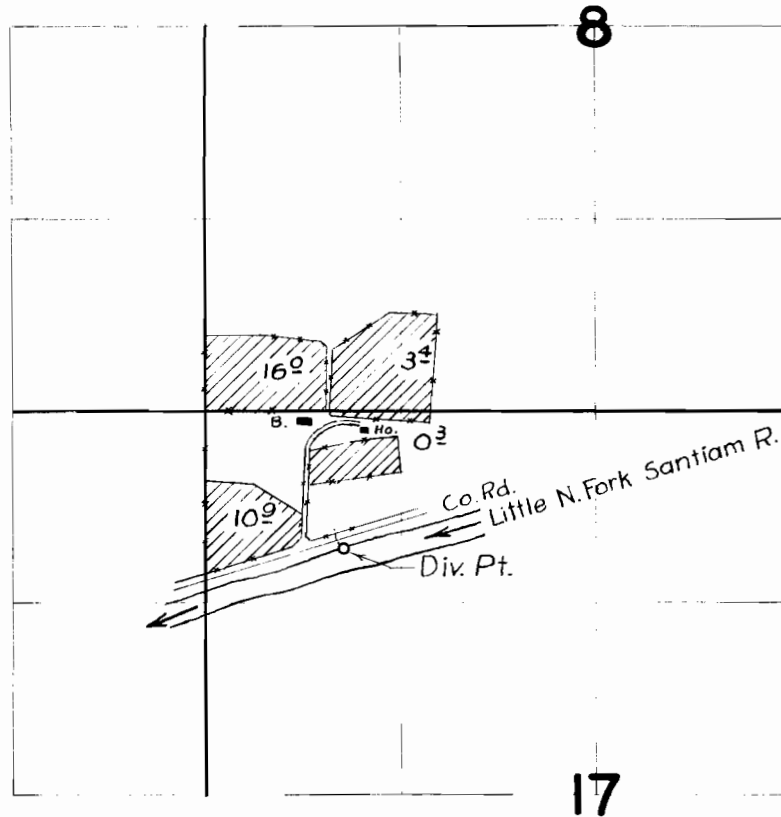

FINAL PROOF SURVEY UNDER

Application No. 25036 ... Permit No. 19723 ...
IN NAME OF

Ben H. Miller

Surveyed Aug. 30, 1957, by *Tom Bish*