


T.17S.R.6W.W.M.

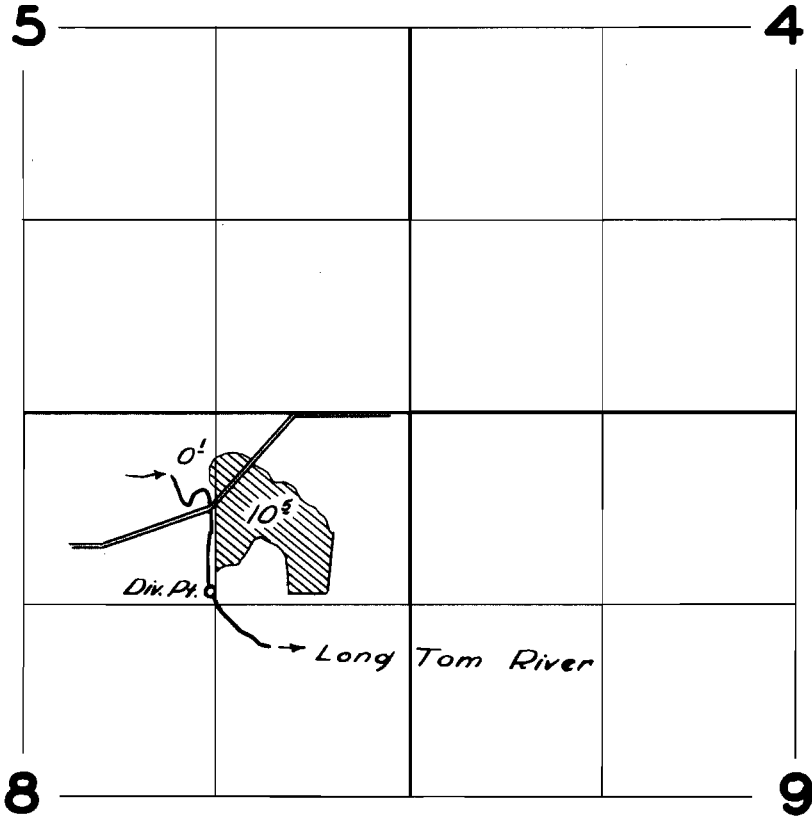

**FINAL PROOF SURVEY**  
UNDER

Application No. 25362 Permit No. 19987  
IN NAME OF

W. H. & ALMA L. BENOIT

Surveyed 1 May 1957, by [Signature]