


T. 6 S. R. 3 W. W.M.

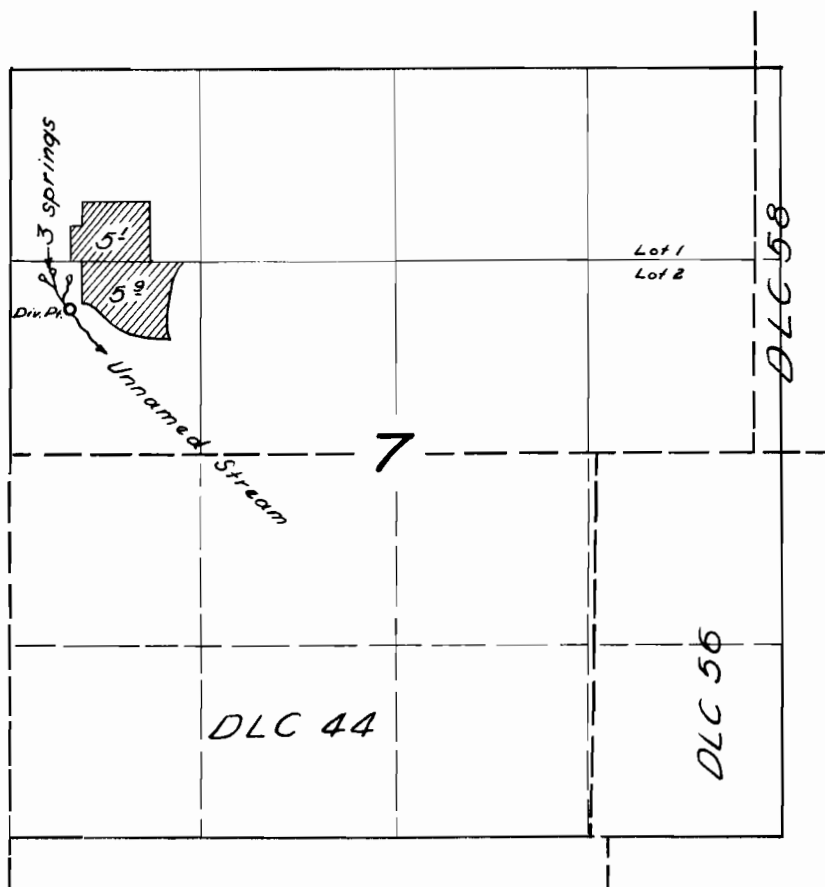

FINAL PROOF SURVEY

UNDER

Application No. 25388 Permit No. 19996

IN NAME OF

MAUDE R. RAE

Surveyed 22 Mar. 1957, by *P. Whitby*