


T.17S.R.6W.W.M.

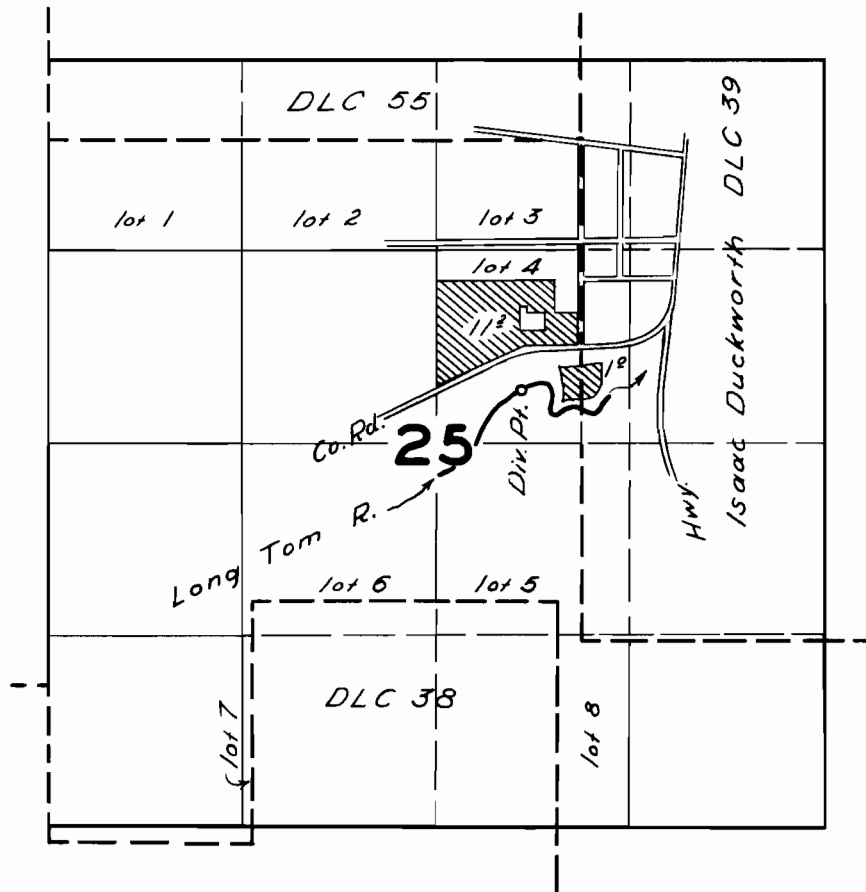

FINAL PROOF SURVEY

UNDER

Application No. 25449 Permit No. 20011

IN NAME OF

W. D. NICHOLS

Surveyed 7 May 1957, by [Signature]