


T.15 & 16 S.R.1 W.W.M.

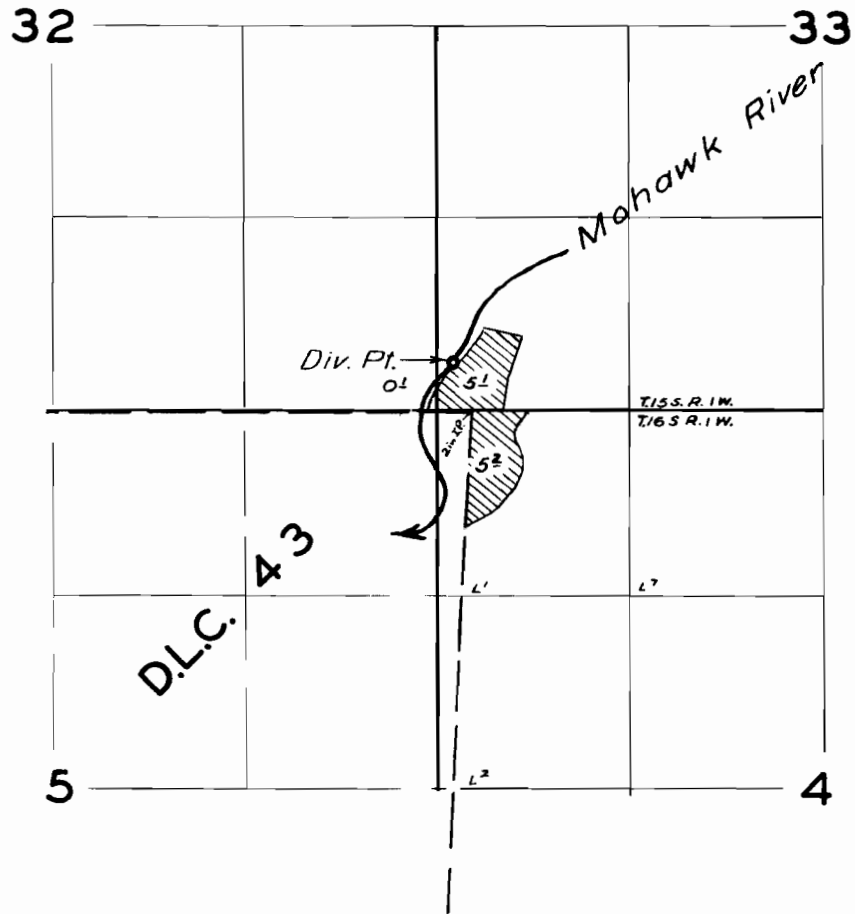

FINAL PROOF SURVEY UNDER

Application No. 25670 Permit No. 20239
IN NAME OF

Robert W. & Virgie Miller

Surveyed June 29 1957, by M. Bish