


T.7S.R.5W.W.M.

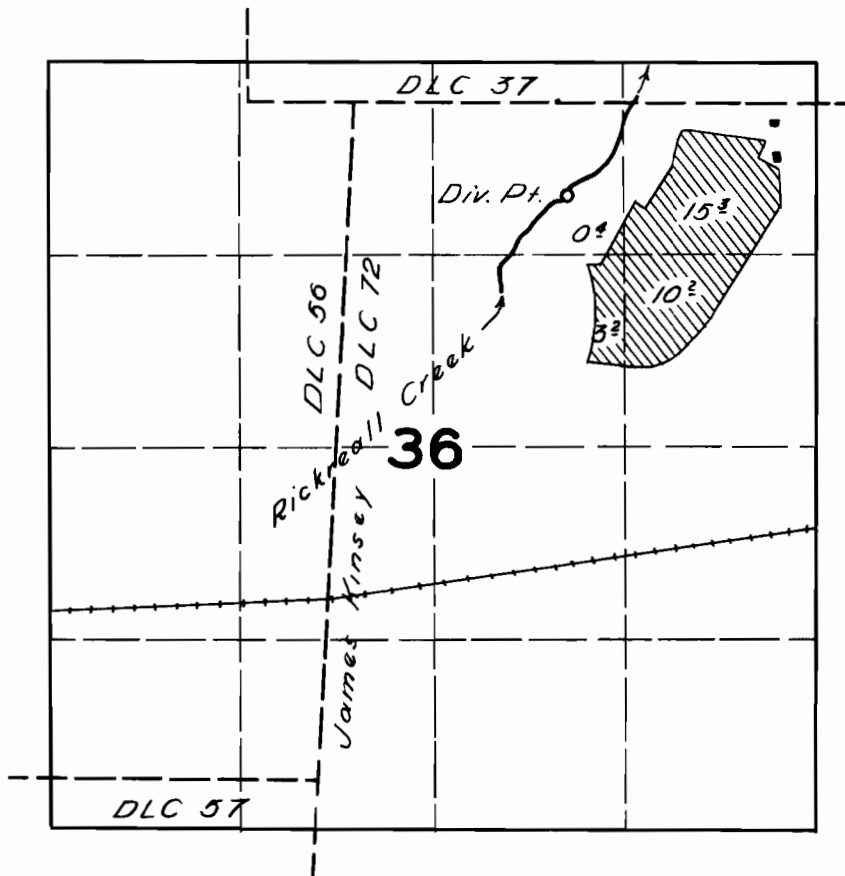

FINAL PROOF SURVEY
UNDER

Application No. 25677 Permit No. 20241
IN NAME OF

W. A. MIDDLETON

Surveyed 3 Apr. 1957, by [Signature]