


T.30S.R.4W.W.M.

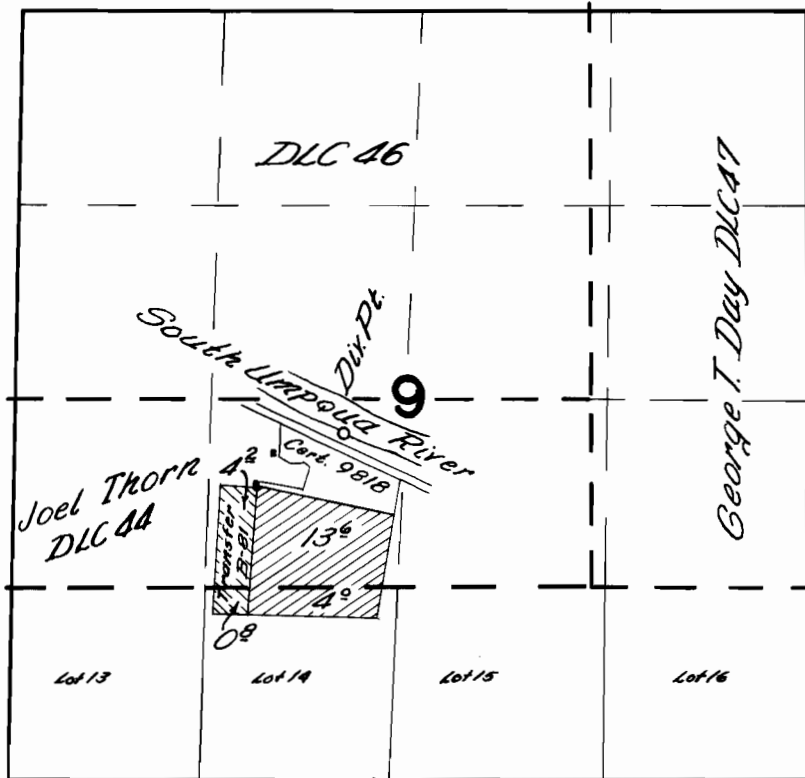

FINAL PROOF SURVEY
UNDER

Application No. 25821 Permit No. 20288
IN NAME OF

W. FRANK BROWN

Surveyed April 16 1957, by C. O. Smith