


T.29 S.R.7W.W.M.

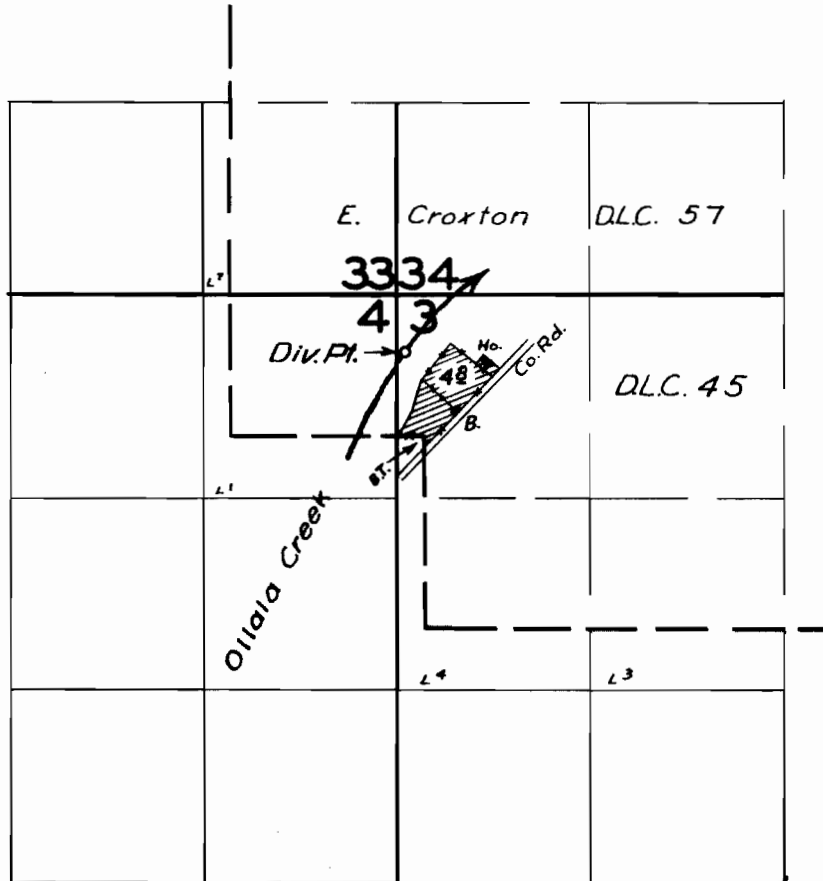

FINAL PROOF SURVEY
UNDER

Application No. 26016 Permit No. 20377
IN NAME OF

Henry Perry

Surveyed July 23, 1957, by M. Bish